


T.9S. R. 27E.W.M.

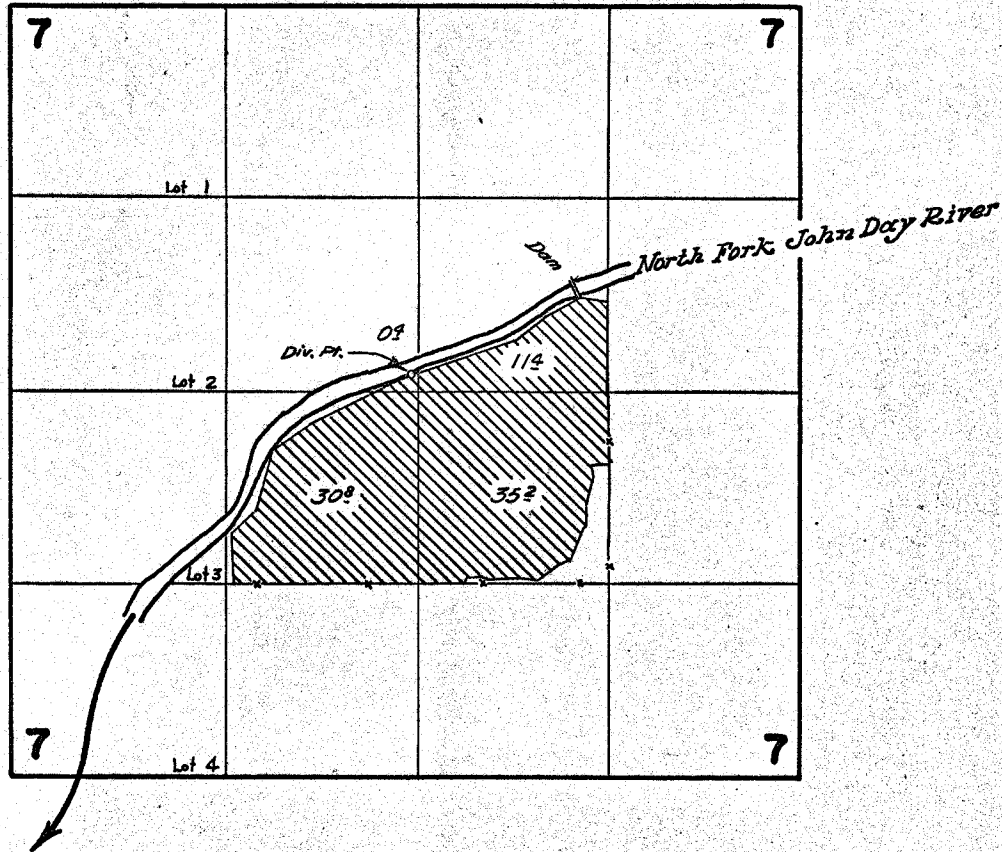

FINAL PROOF SURVEY UNDER

Application No. 30637 Permit No. 24136
IN NAME OF

LEWIS D. NEAL

Surveyed August 29, 1961, by R. Jackson