


T.13S.R.28E.W.M.

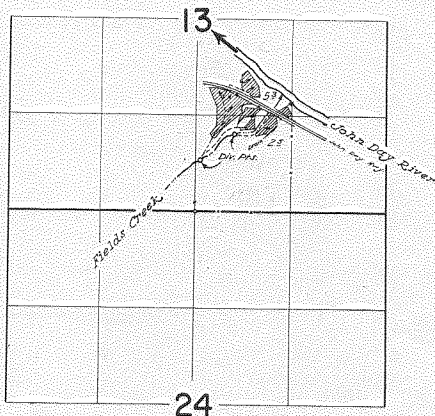

FINAL PROOF SURVEY
UNDER

Application No. 31770 . Permit No. 25087.
IN NAME OF

E. R. MOORE

Surveyed August 20 1961. by

L. A. Johnson