


T.27S.R.36E.W.M.

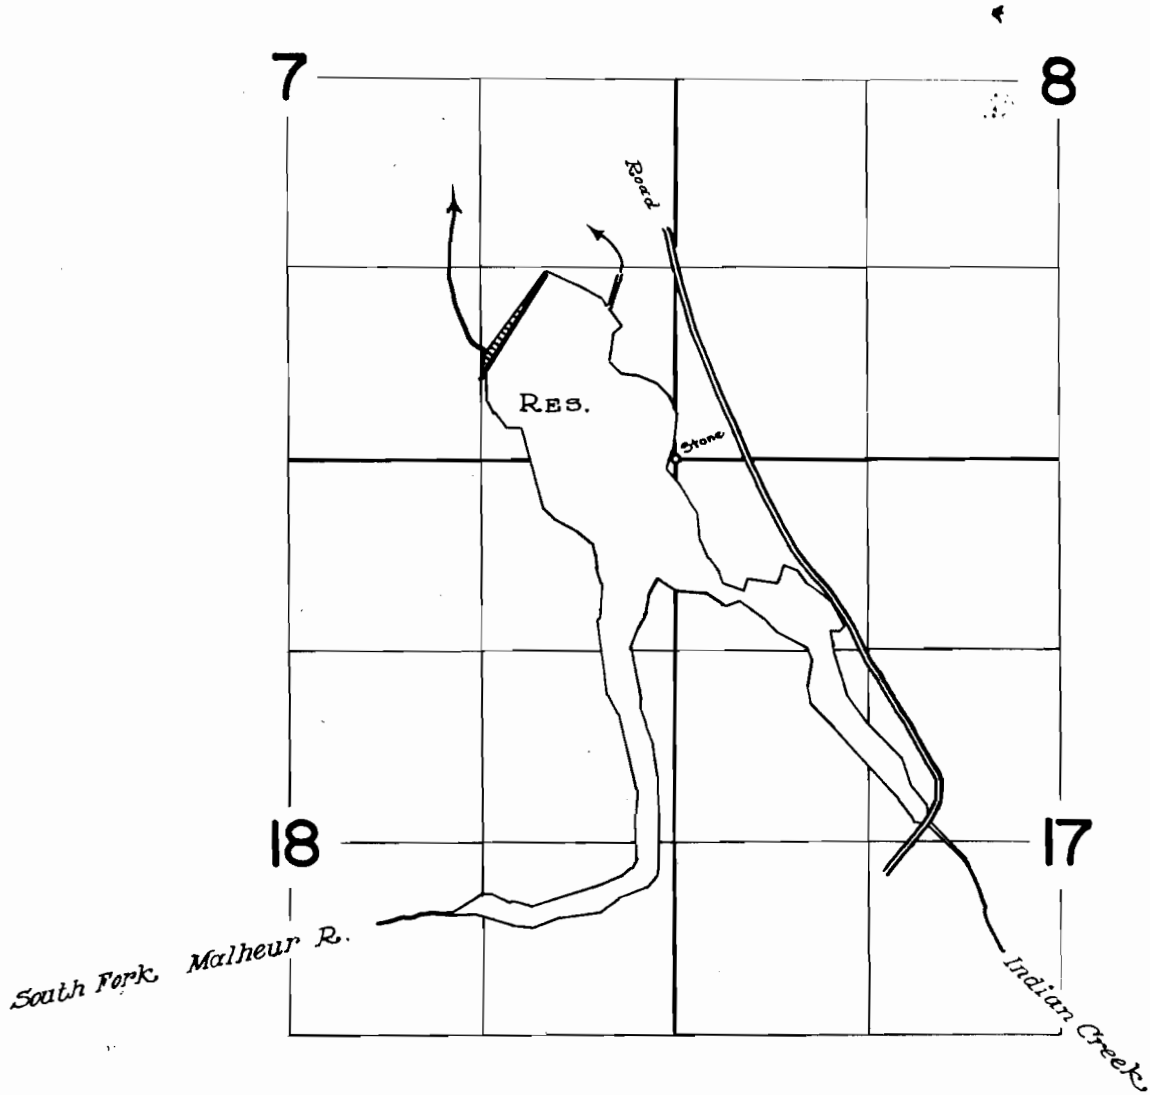

FINAL PROOF SURVEY
UNDER

R-22784 R-902
R-23234 R-941
Application No. R-25412-Permit No. R-1083
IN NAME OF

Surveyed Aug. 8 & 11 1958, by M. Bish
Oct. 19 1960 *R. H. Johnson*