


T.27S.R.36E.W.M.

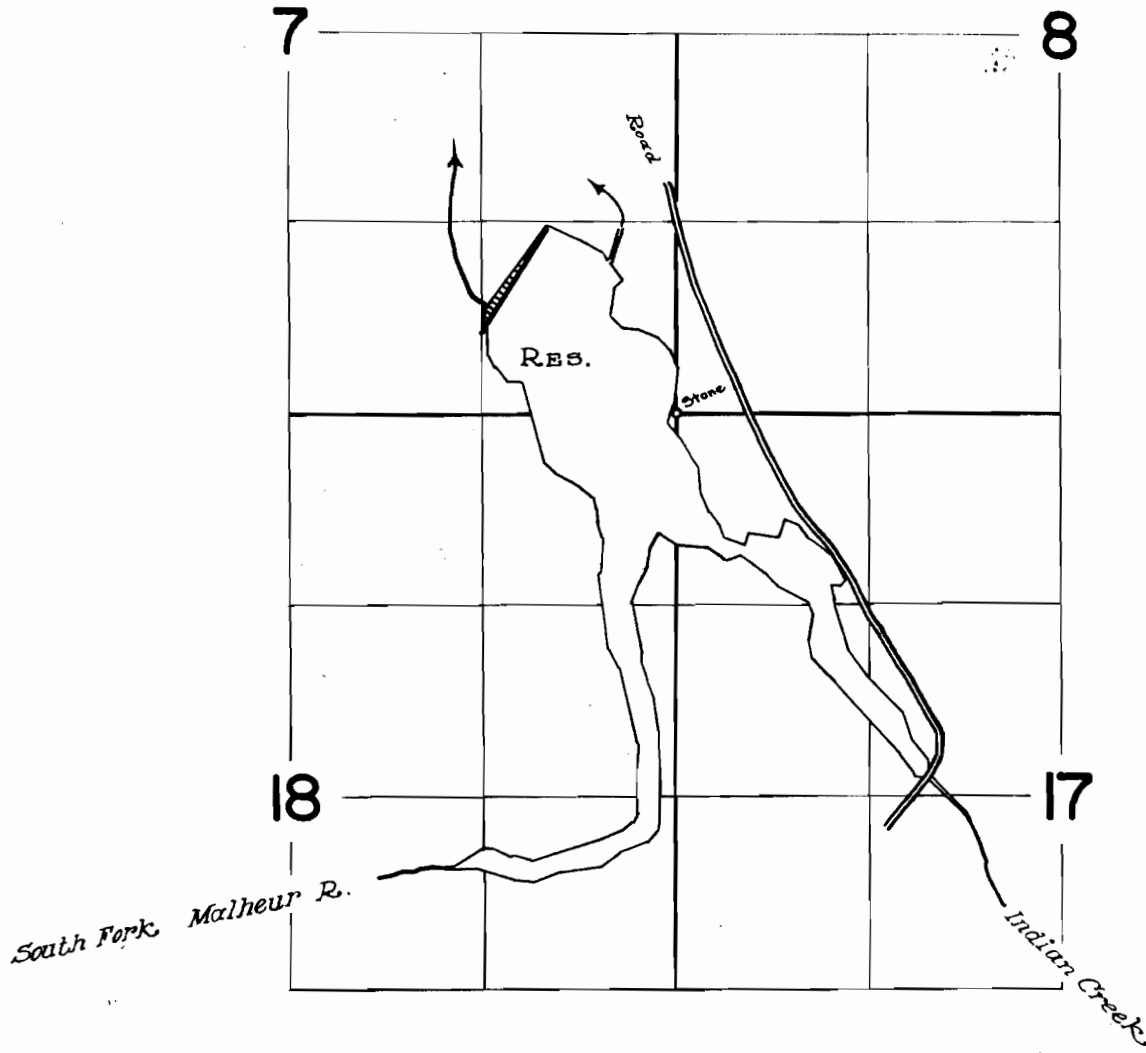

FINAL PROOF SURVEY  
UNDER

R-22784                      R-902  
R-23234                      R-941  
Application No. R-25412-Permit No. R-1083  
IN NAME OF

Surveyed Aug. 8 & 11 1958, by M. Bish  
Oct. 19 1960 *R. Peterson*