


T.26&27 S.R.36E.W.M.

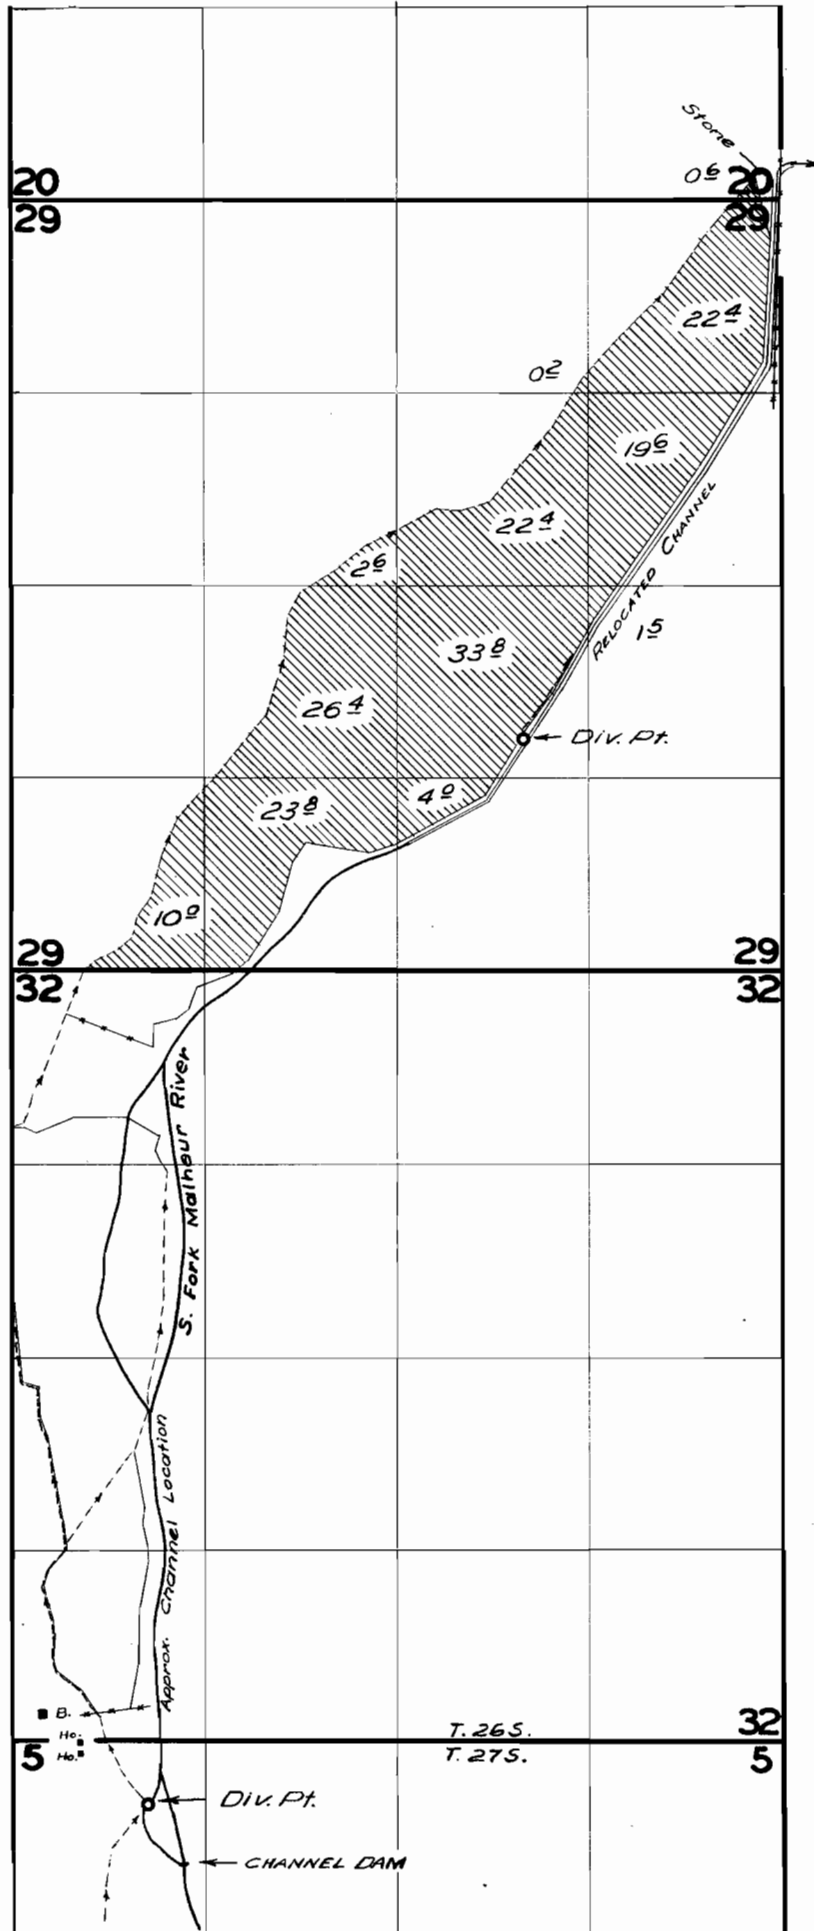

FINAL PROOF SURVEY

UNDER

Application No. 22785 Permit No. 17977
23235 18348
25413 19897

IN NAME OF

MARVIN E. YOUNG

Surveyed 8/11 Aug. 19 58, by Tom Bishop