
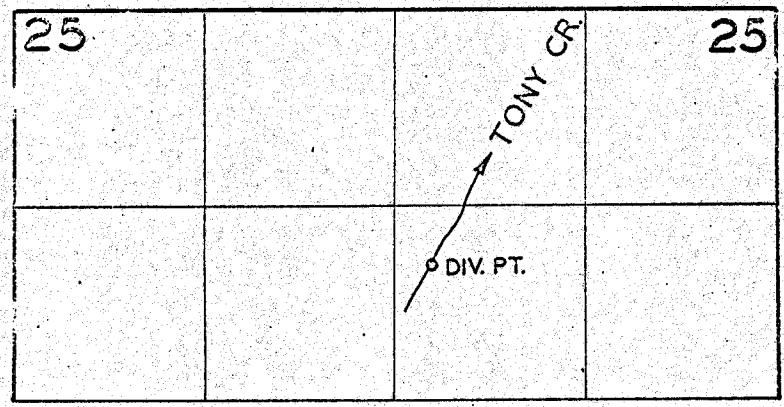


17172

# T. IN. R. 9 E. W. M.

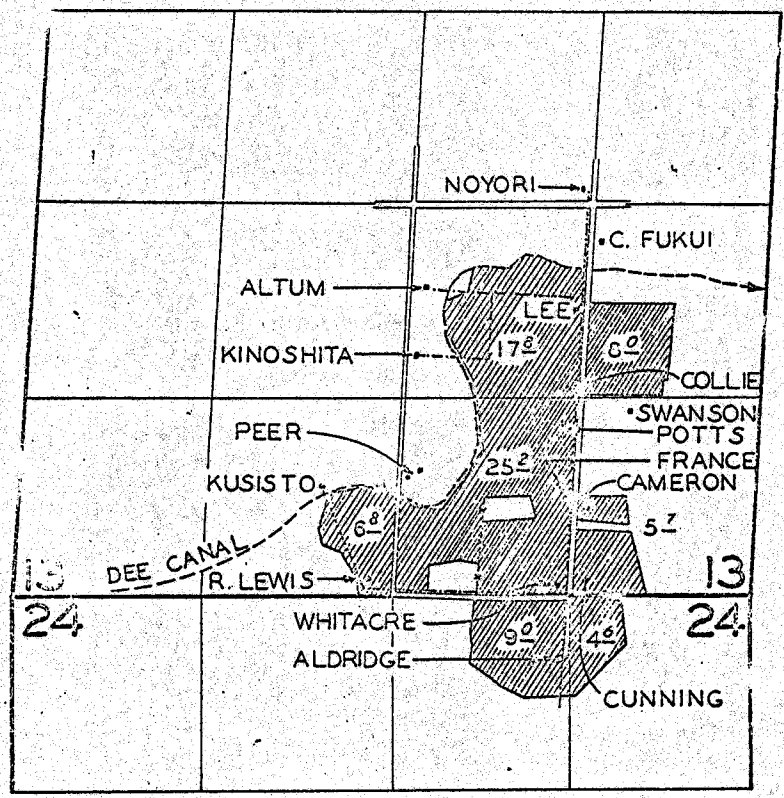

## FINAL PROOF SURVEY UNDER

Application No. 20567 21833 Permit No. 16118 17172  
IN NAME OF

**ALDRIDGE DITCH COMPANY**

Surveyed JUNE 4&5 1958., by C.O. BARTELS....