
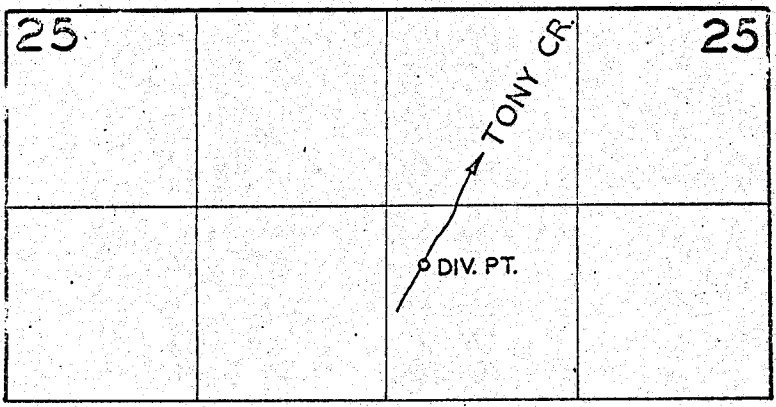


17172

# T.1N. R.9E.W.M.

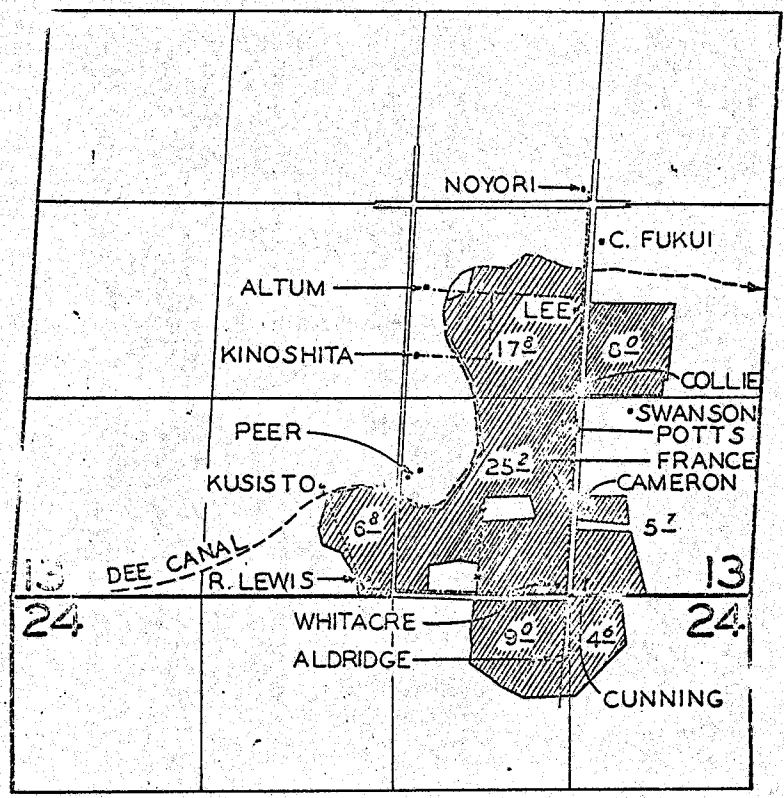

## FINAL PROOF SURVEY UNDER

Application No. <sup>20567</sup> 21,833..... Permit No. <sup>16118</sup> 17,172.....  
IN NAME OF

**ALDRIDGE DITCH COMPANY**

Surveyed JUNE 4&5 1958., by C.O. BARTELS....