


T. 37 S., R. 1 W., W.M.

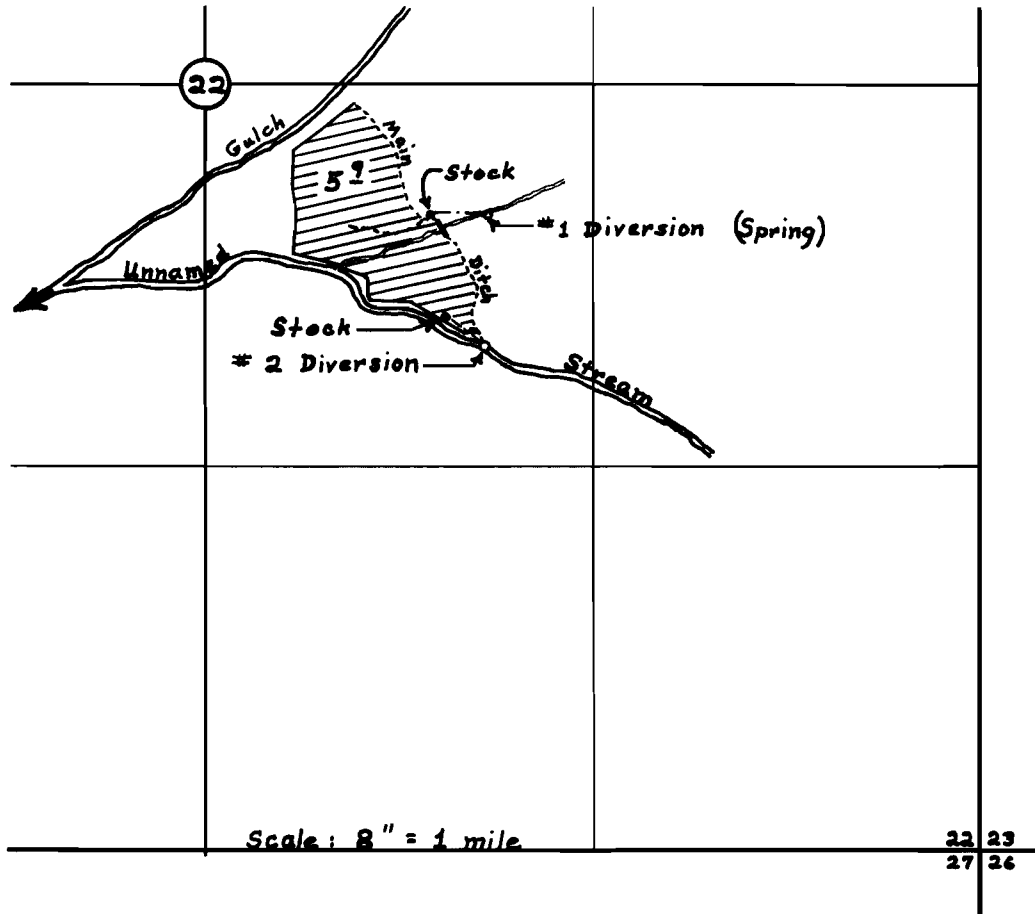

## FINAL PROOF SURVEY UNDER

Application No. 30465 Permit No. 23996  
IN NAME OF

Byron Coleman by S. E. Hansen

Surveyed April 3, 1962, by D. L. Hendrix