


T.38S.R.11 1/2 E.W.M.

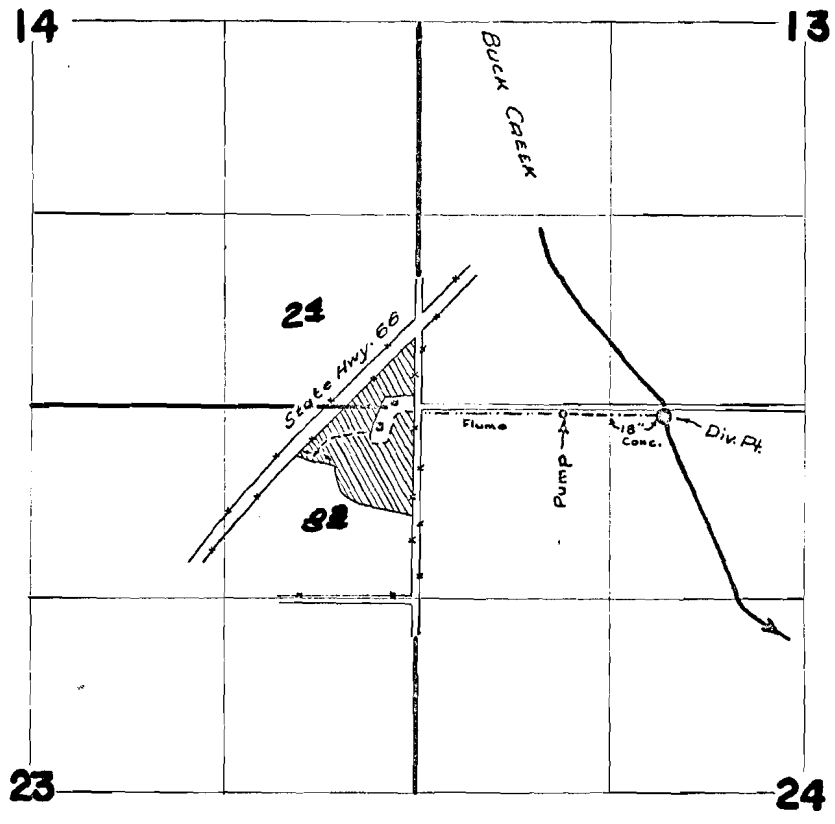

FINAL PROOF SURVEY UNDER

Application No. 28227 Permit No. 22812
IN NAME OF

A.M. LEPLEY

Surveyed 17 JULY 1961, by M. Bish