


T.17S.R.7W.W.M.

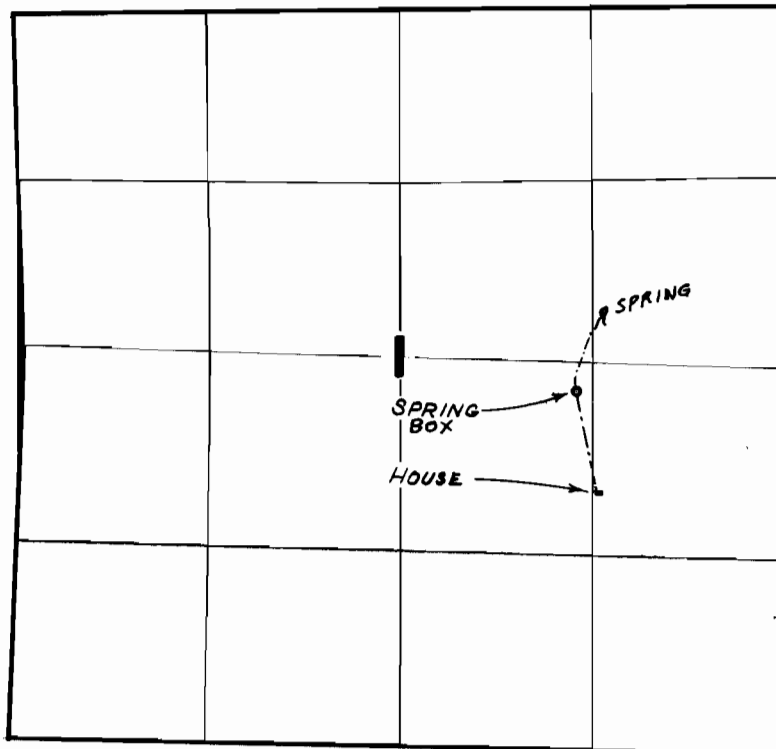

FINAL PROOF SURVEY
UNDER

Application No. 32809... Permit No. 25900...
IN NAME OF

.....*DEWEY A. HERBERT*.....

Surveyed *MAY 3* 19*60*, by *C.O. BARTELS*
MAY 23 19*61*