


T.20S.R.3W.W.M.

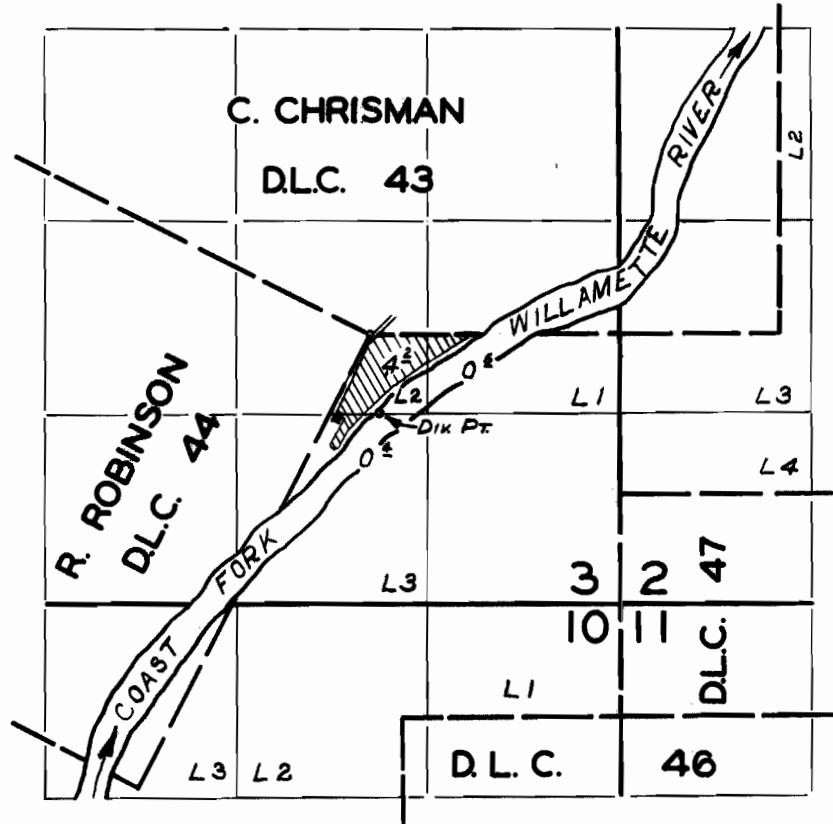

FINAL PROOF SURVEY
UNDER

Application No. 33283... Permit No. 26306....
IN NAME OF

JAMES A. LANG

Surveyed *Mar. 26. 1961.*, by *M. BISH*.....