


T.I.S.R.8W.W.M.

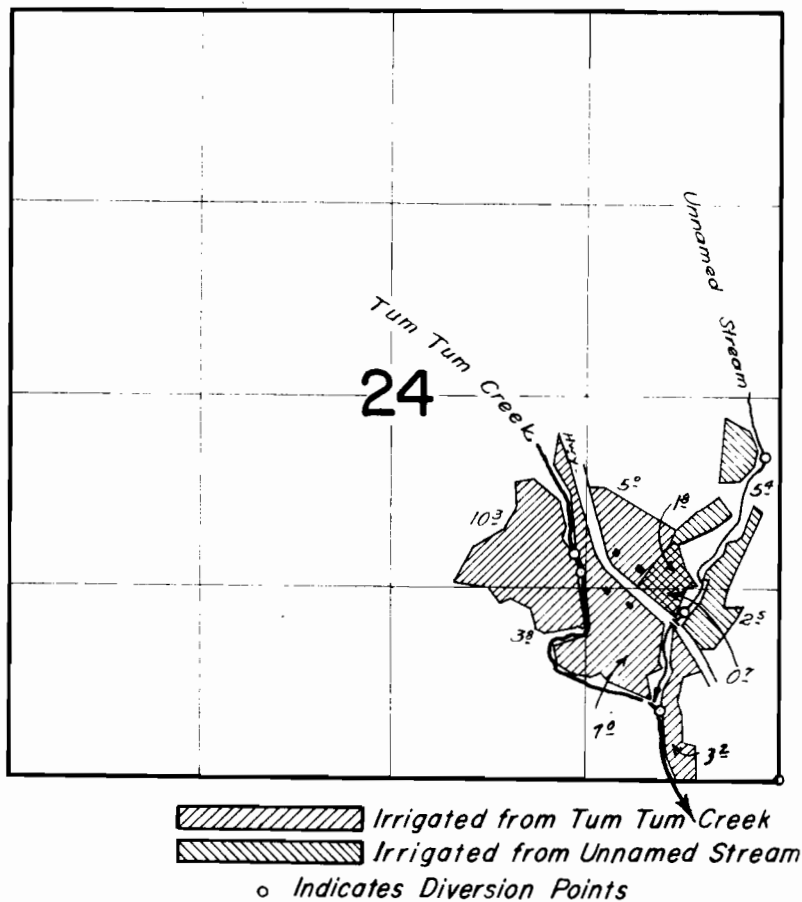

FINAL PROOF SURVEY
UNDER

Application No. **26346** **32244** Permit No. **20671** **25479**
IN NAME OF

HANYAN J. KASNER

Surveyed *Sept 7-8 1961* by *C.O. Bartels*