


T.10 S. R. 8 W. W.M.

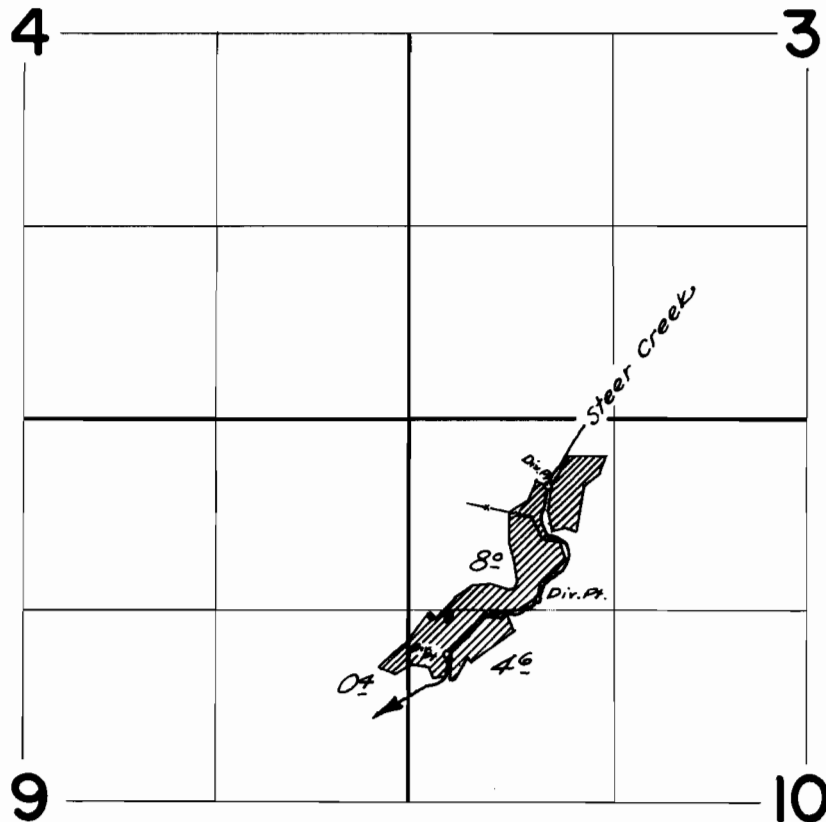

FINAL PROOF SURVEY
UNDER

Application No. 26750 Permit No. 20929
IN NAME OF

JAMES E. CHAMBERS, SR.

Surveyed Sept. 29, 1961, by R. Jackson