


T.11S. R. 8 W.W.M.

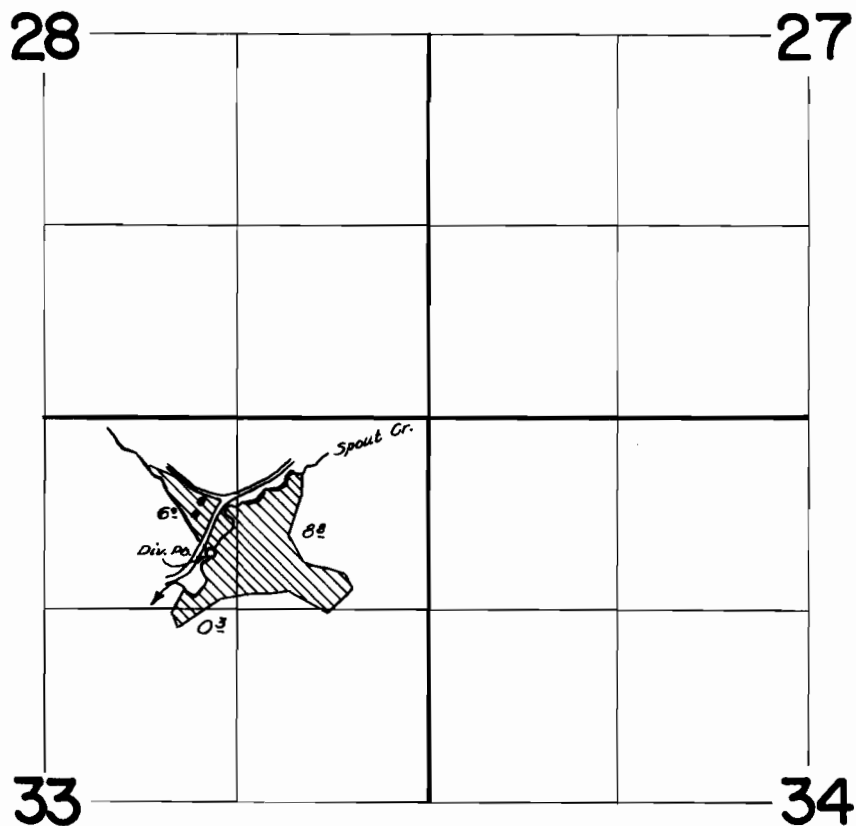

FINAL PROOF SURVEY
UNDER

Application No. 27029..... Permit No. 21271.....
IN NAME OF

EUGENE COOPER

Surveyed Sept. 7, 1961, by C.O. Bartels.....