


T.11S. R.9 W.W.M.

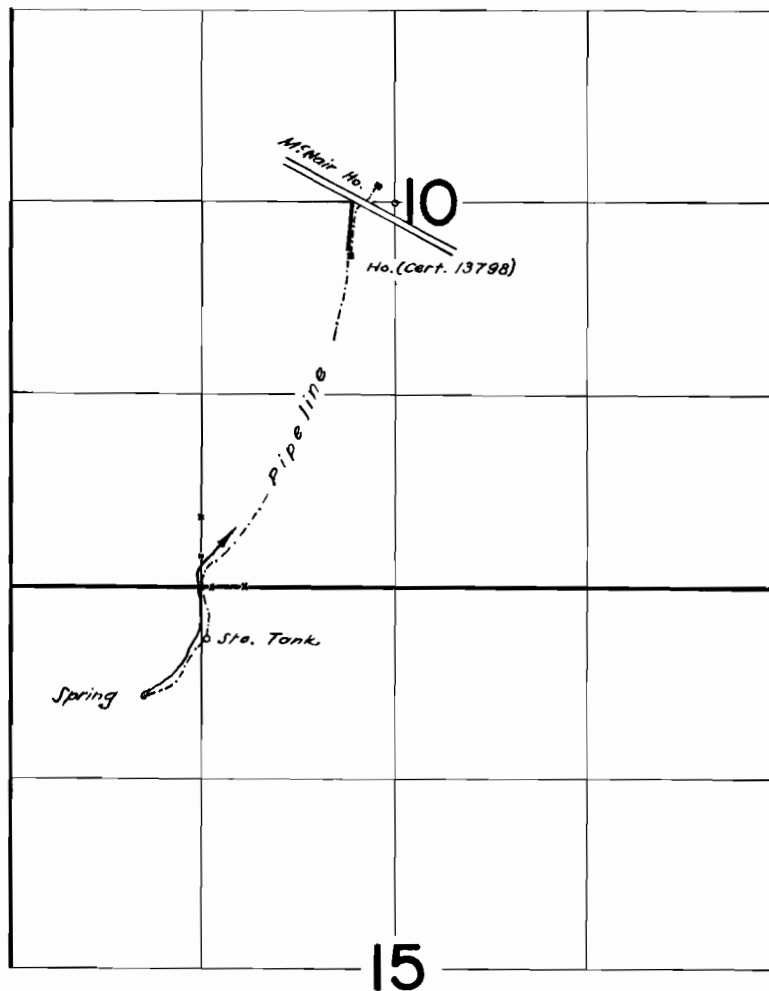

FINAL PROOF SURVEY
UNDER

Application No. **29056**... Permit No. **22855**...
IN NAME OF

WM. R. & MARION S. MCNAIR

Surveyed *August 8, 1960*, by *M. Bish*.....
Sept. 8, 1961, by *Jackson*