


# T.9 S. R.9 W.W.M.

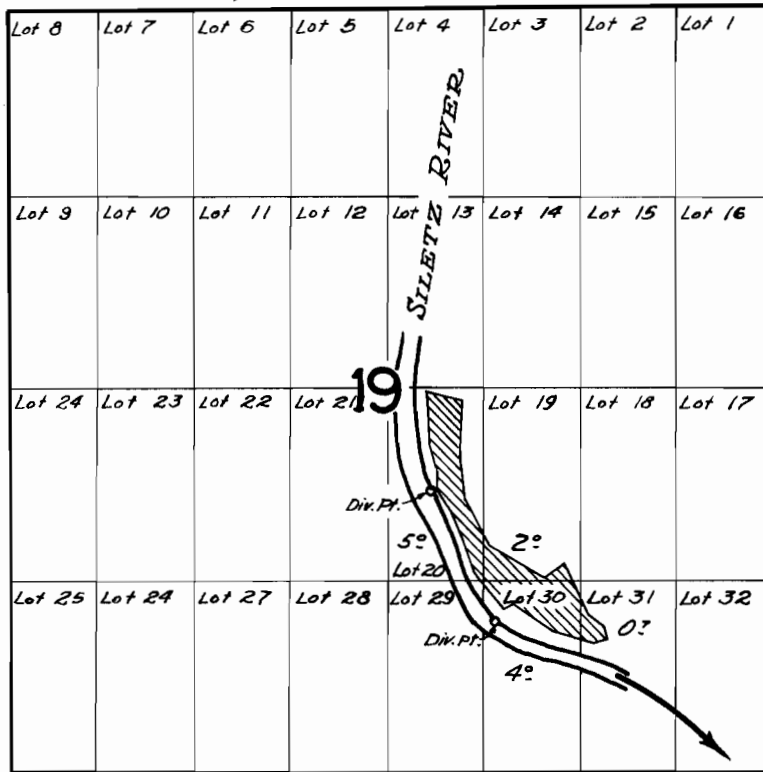

## FINAL PROOF SURVEY UNDER

Application No. 31617 Permit No. 24941  
IN NAME OF

Blair Mitchell & Lester Pickens

Surveyed Sept. 25, 1961, by *R.H. Johnson*