


T.IIS.R.9W.W.M.

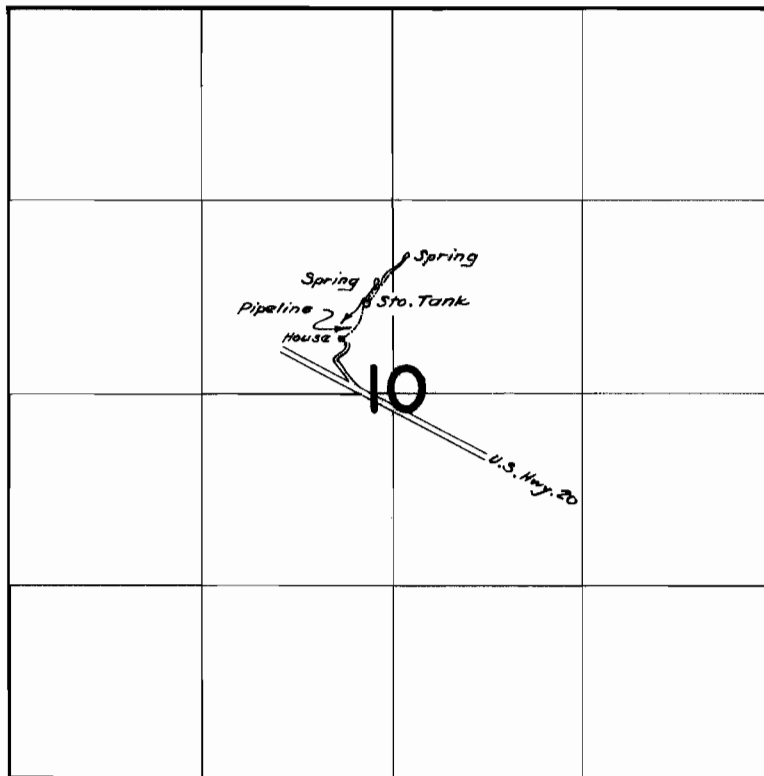

FINAL PROOF SURVEY
UNDER

Application No. 33482 Permit No. 26470
IN NAME OF

FREDERICK ERNEST RUPRECHT

Surveyed Sept. 8, 1961, by R. Jackson