


T.I.S.R. 4W.W.M.

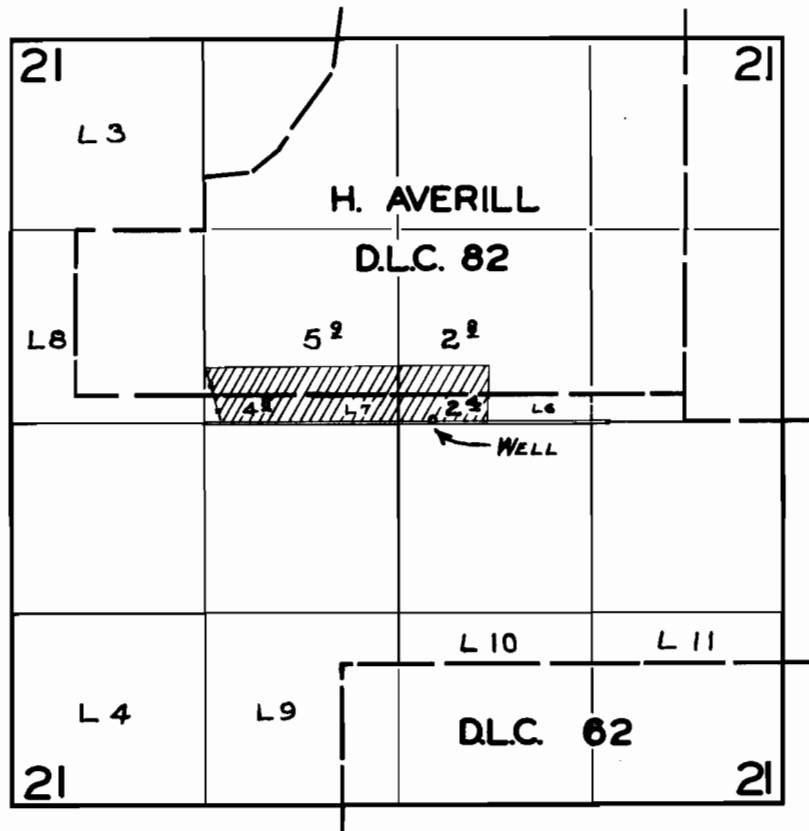

FINAL PROOF SURVEY UNDER

Application No. G-926 Permit No. G-808
IN NAME OF

ALVIN & VIVA CARNEGIE

Surveyed SEPT. 7, 1961, by M. BISH