


T. 9 S. R. 1 W. W. M.

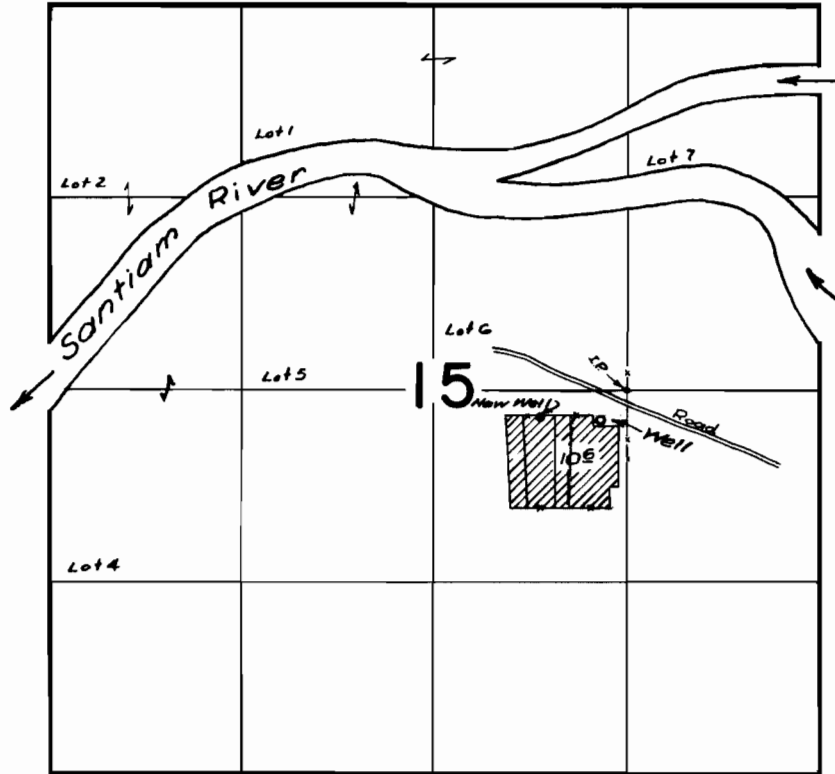

FINAL PROOF SURVEY UNDER

Application No. G-1253 Permit No. G-1081
IN NAME OF

DEWITT TIGER

Surveyed 16 MAY 1961, by Tom Bish