


T.10S.R.3W.W.M.

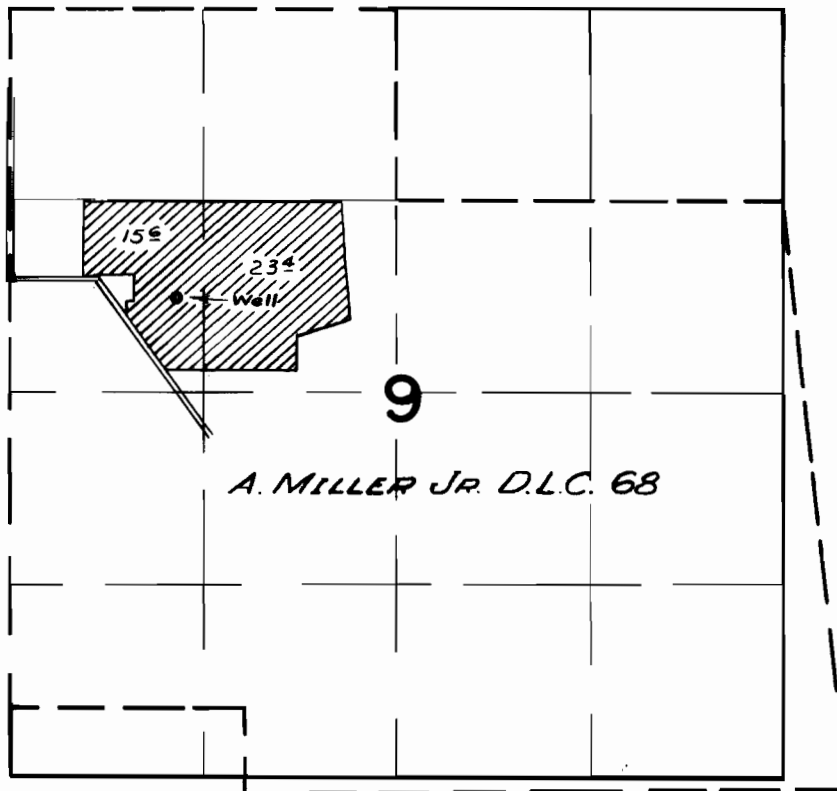

FINAL PROOF SURVEY
UNDER

Application No. G-1393 Permit No. G-1257
IN NAME OF

CECIL E. COX

Surveyed 19 MAY 1961, by Tr. Bish