


T. 11 S. R. 2 W. W. M.

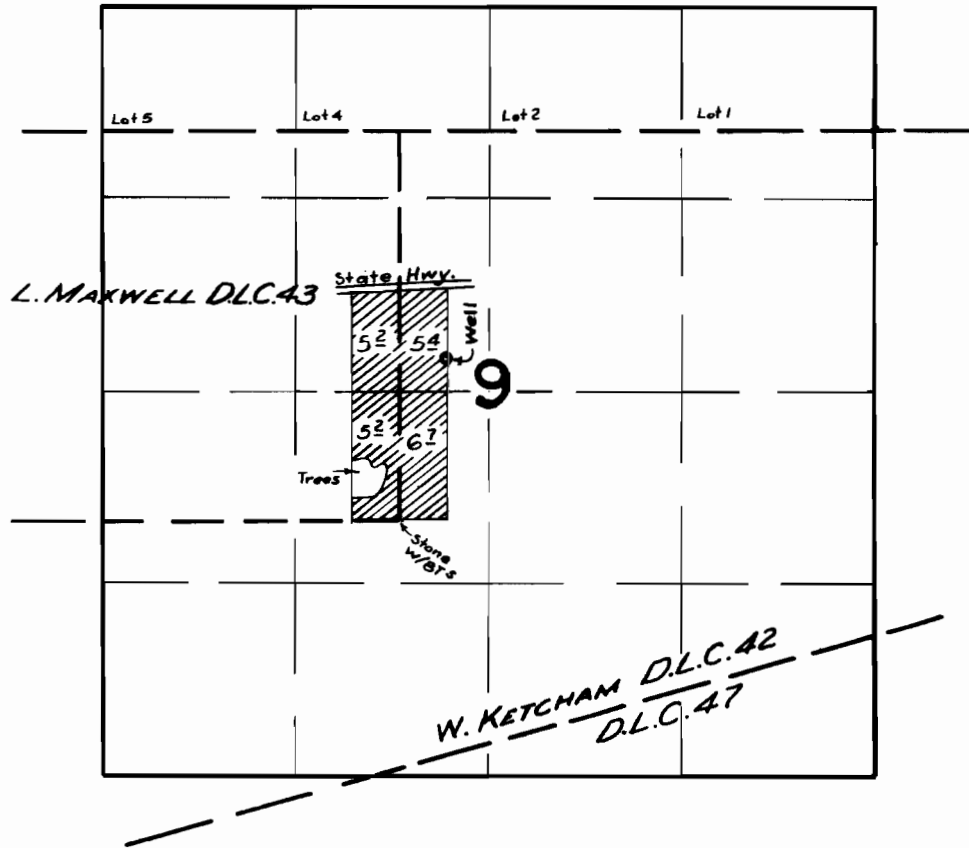

FINAL PROOF SURVEY UNDER

Application No. G-1523 Permit No. G-1400
IN NAME OF

OTTO CHRISTENSEN

Surveyed 31 MAY 1961, by Mo. Bish