


T. 10S. R. 1 W. W. M.

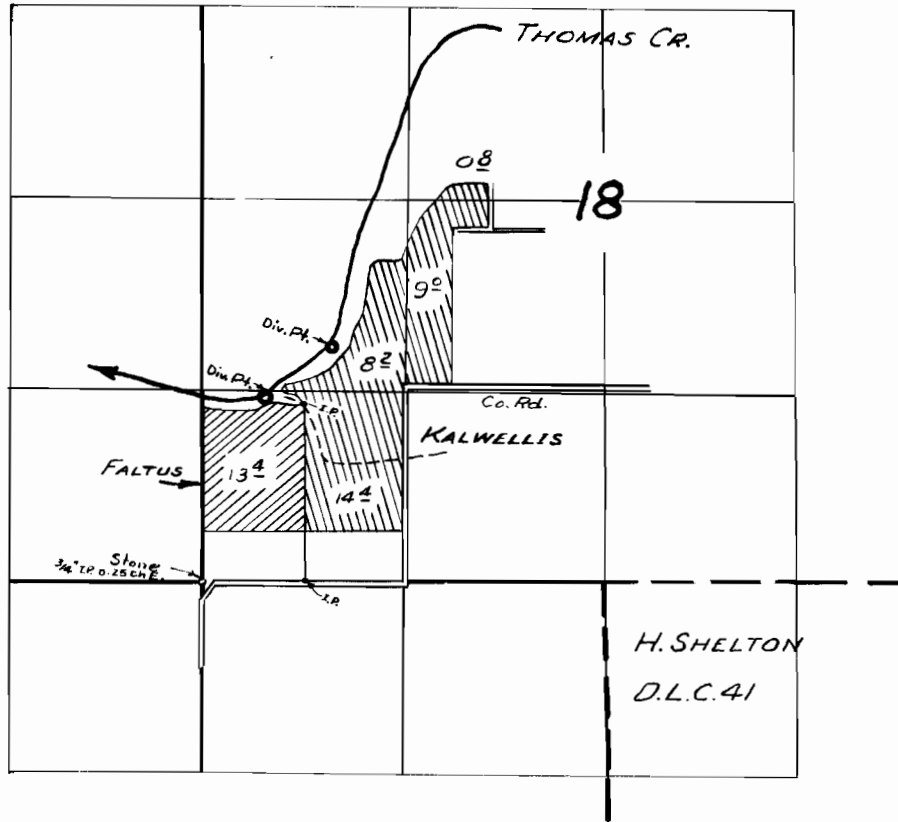

H. SHELTON
D.L.C. 41

30248

23840

JERRY M. FALTUS
LYDIA & WILHELM KALWELLIS

15 MAY 61

M. Bish