


T. 10 S. R. 3 W. W.M.

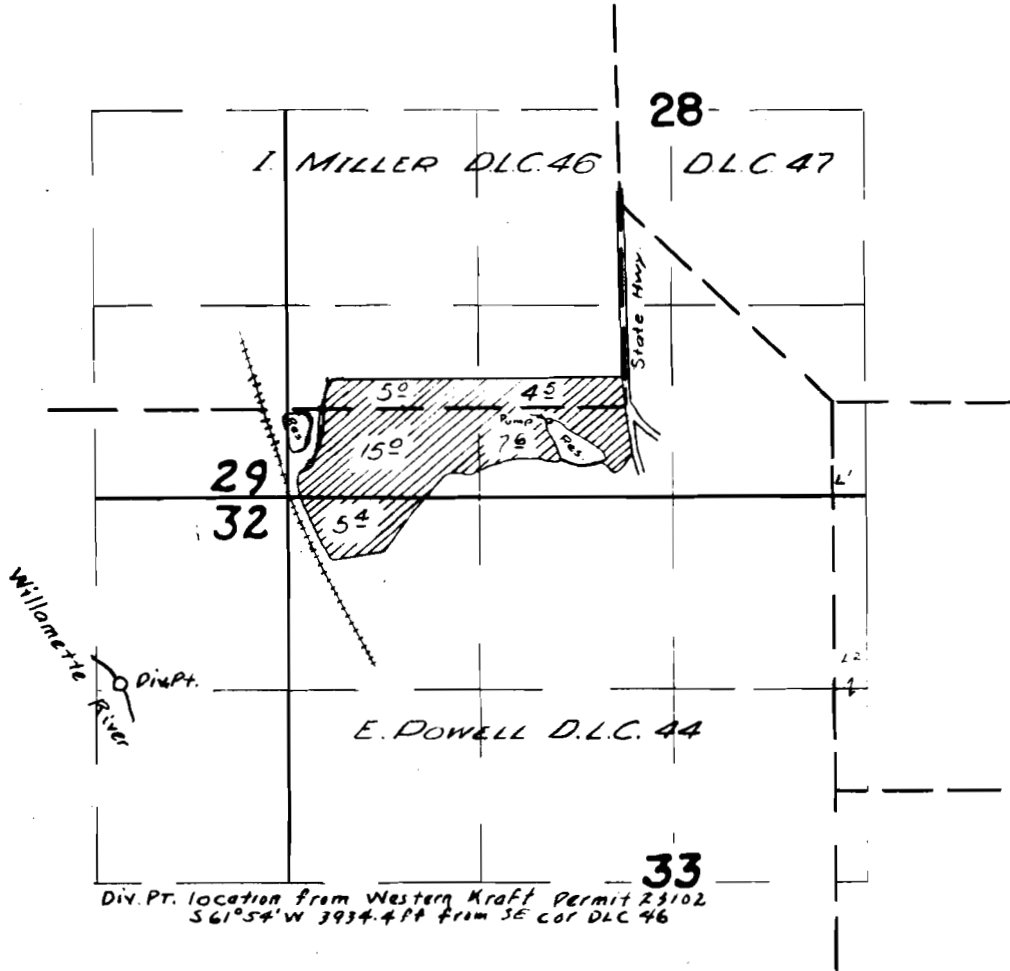

FINAL PROOF SURVEY
UNDER

30280 23848
Application No. R-30279 Permit No. R-1797
IN NAME OF

LINN-BENTON MEMORIAL PARK ASSOC.

Surveyed 18 MAY 1961, by *M. Bish*