


# T.I.S.R.I.E.W.M.

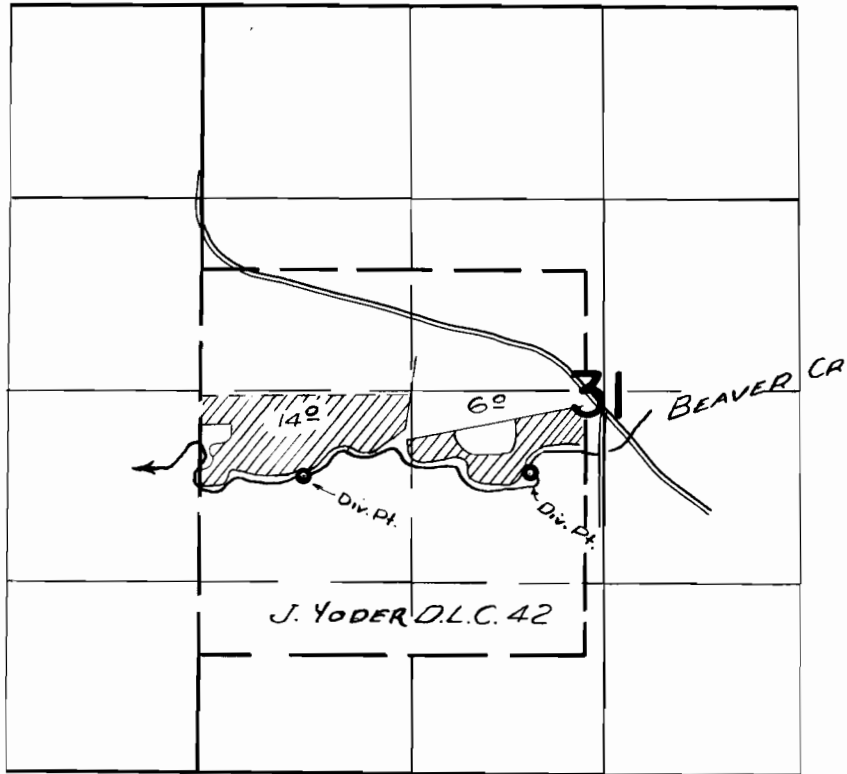

## FINAL PROOF SURVEY UNDER

Application No. 30349 Permit No. 23873  
IN NAME OF

EARL F. & MARTHA KLEINSCHMIDT

Surveyed 6 JUNE 1961, by Tom Bish