


T.10S.R.3W.W.M.

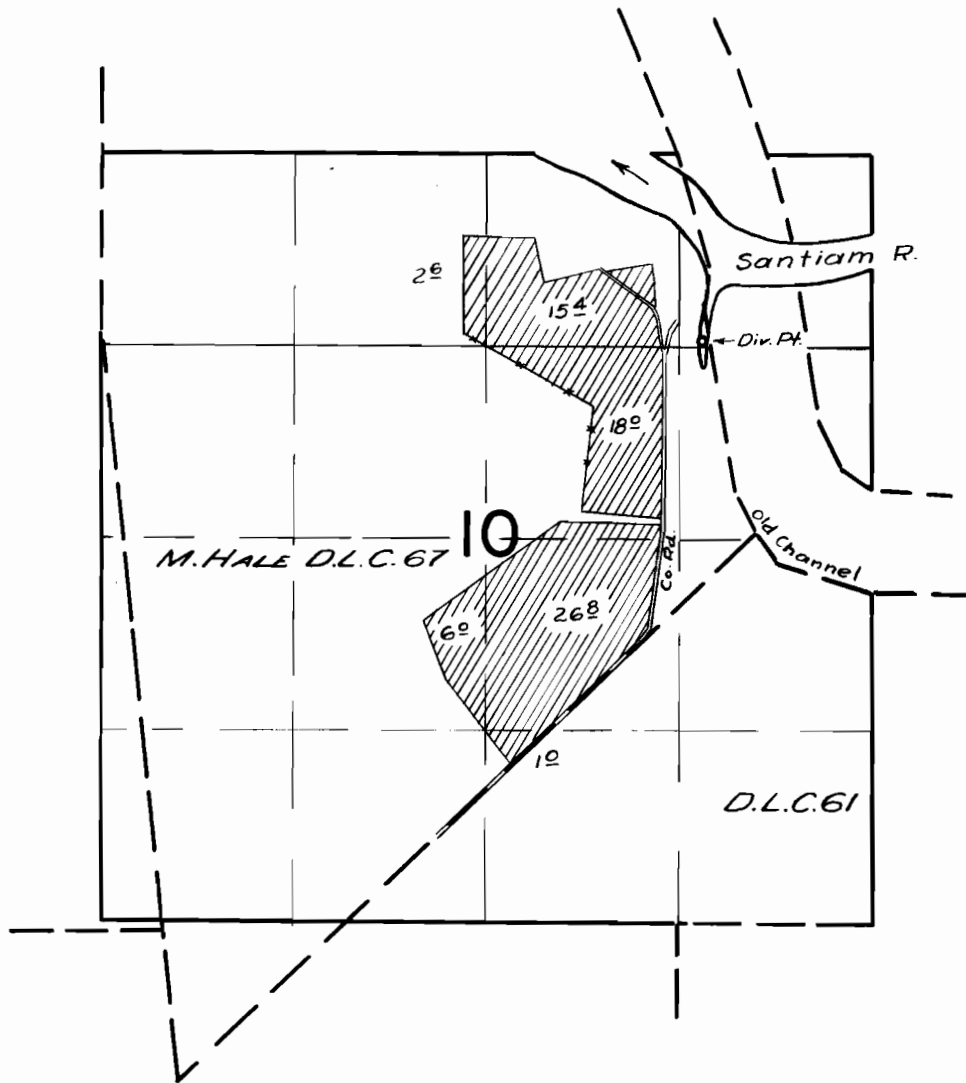

FINAL PROOF SURVEY
UNDER

Application No. 31737 Permit No. 25035
IN NAME OF

WALTER E. & VIRGINIA A. KREGER

Surveyed 2 JUNE 1961, by Mo. Bush