


T. 10 S. R. 3 W. W.M.

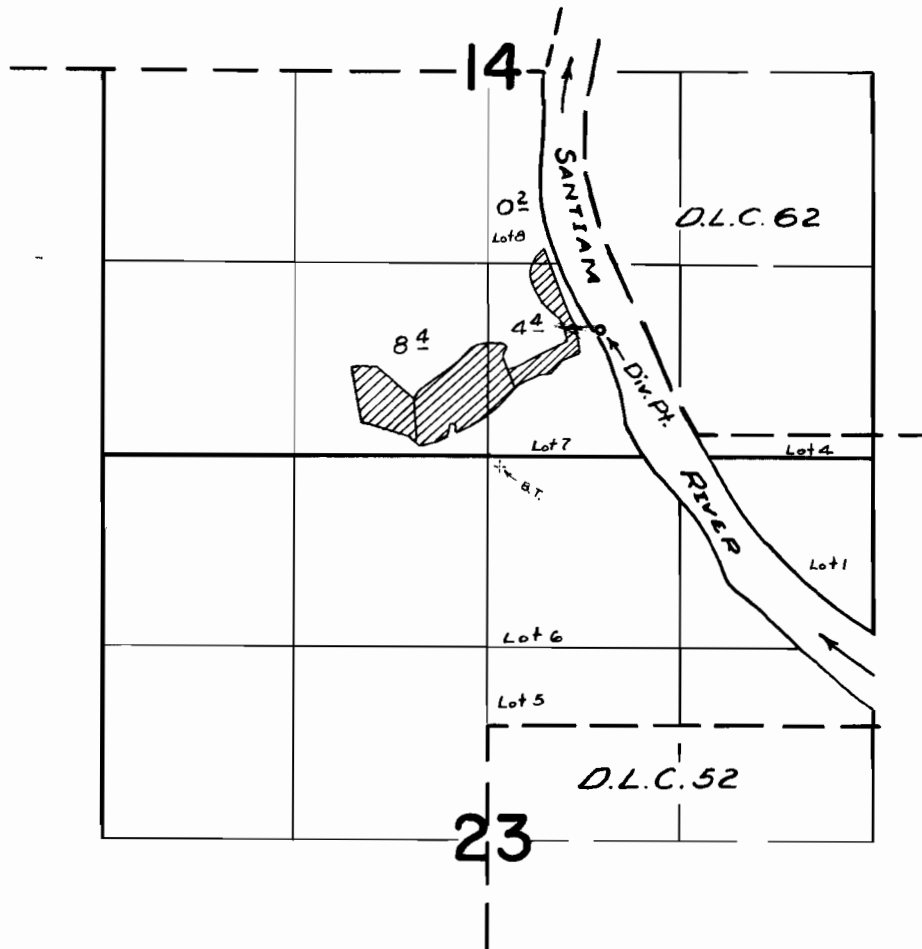

**FINAL PROOF SURVEY**  
UNDER

Application No. 32067 Permit No. 25319  
IN NAME OF

LLOYD J. PORTER

Surveyed 2 JUNE 1961, by m. Bish