
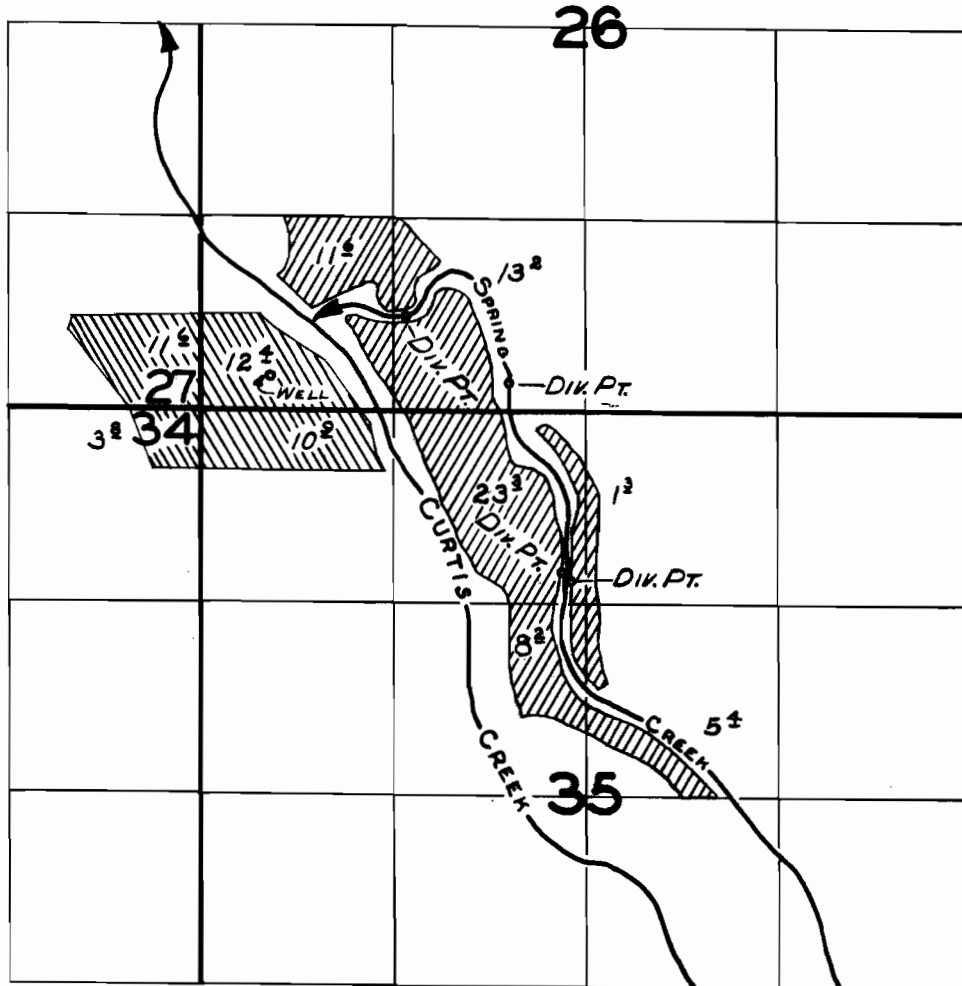


T.15S.R. 4W.W.M.

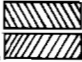

FINAL PROOF SURVEY

UNDER

Application No. G-1467 Permit No. G-1347 

IN NAME OF

HOWARD J. & KATHERINE BOWERS

Surveyed JUNE 21 1961, by M. BISH