


T.11S.R. 4W.W.M.

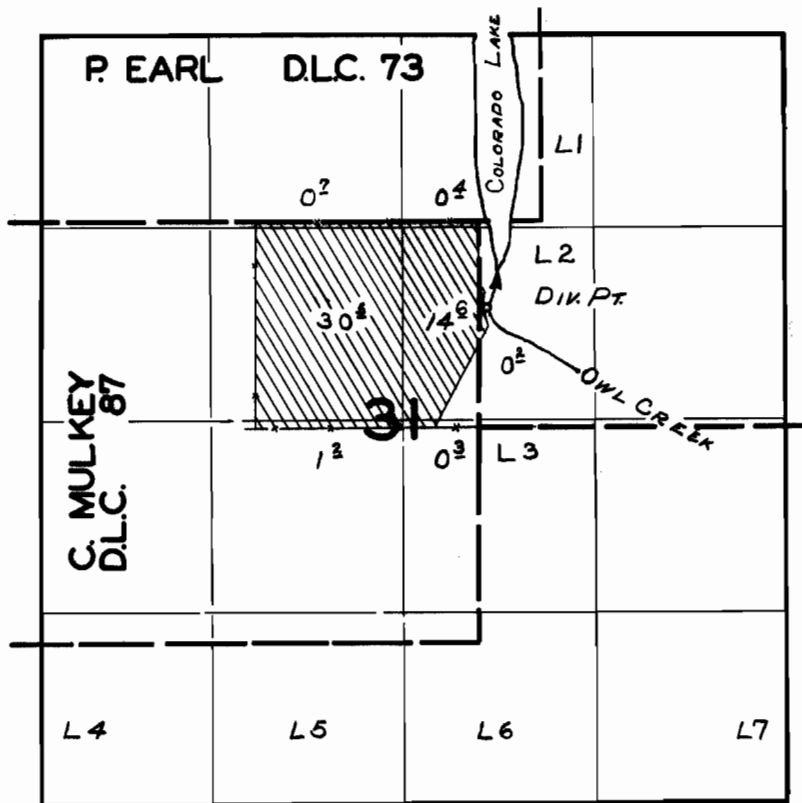

FINAL PROOF SURVEY
UNDER

Application No. 33702... Permit No. 26638...
IN NAME OF

ALBERT L. & BETH GREGORY

Surveyed Sept. 7, 1961, by M. Bush