


T.27S.R.38E.W.M.

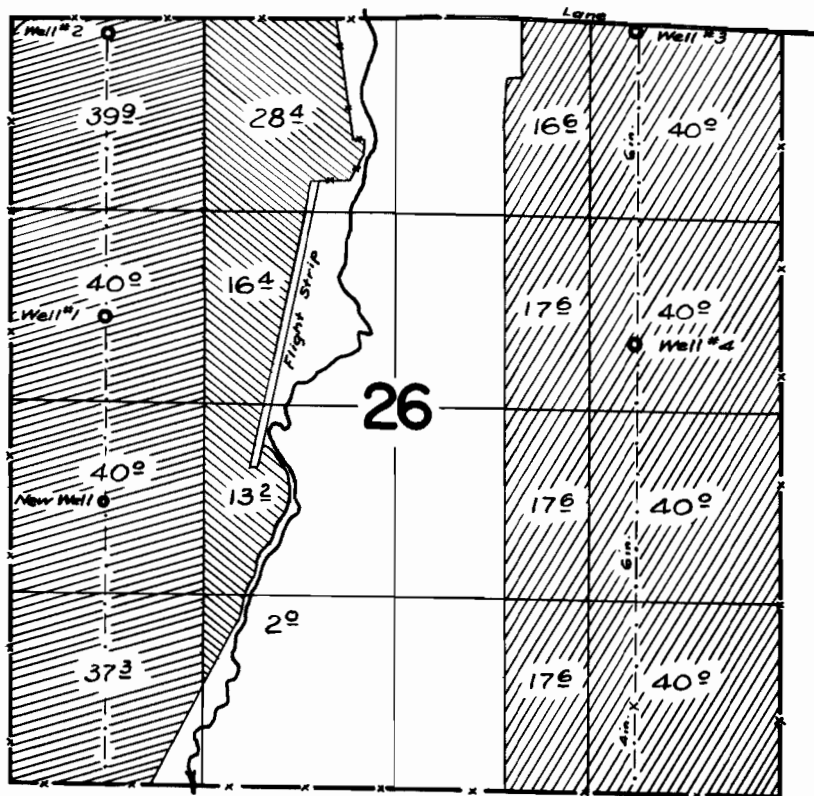

WELL No. 2 Suppl. Primary
WELLS No. 3 & 4 Primary

FINAL PROOF SURVEY
UNDER

Application No. G-1281 Permit No. G-1127
IN NAME OF

HAROLD C. HUTCHINSON,

Surveyed 19 Oct. 1961, by M. Bish