


T.4S.R.1W.W.M.

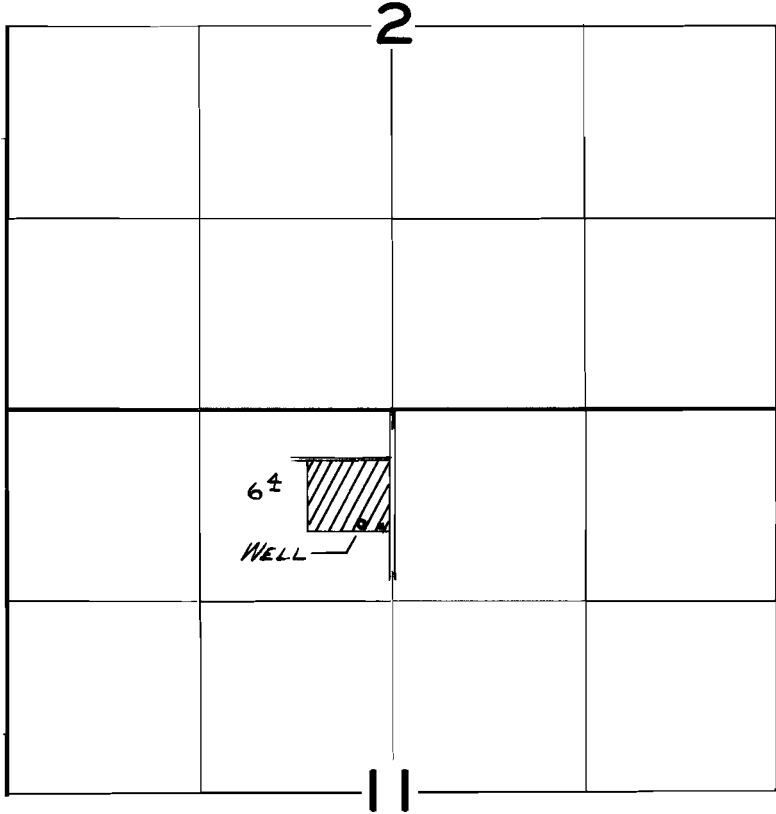

FINAL PROOF SURVEY
UNDER

Application No. *G-1635* Permit No. *G-1531*...
IN NAME OF

LESLIE C. KLEVE

Surveyed *Sept. 28 1961*, by *C.O. BARTELS*...