


T. 7S. R. 3 W. W.M.

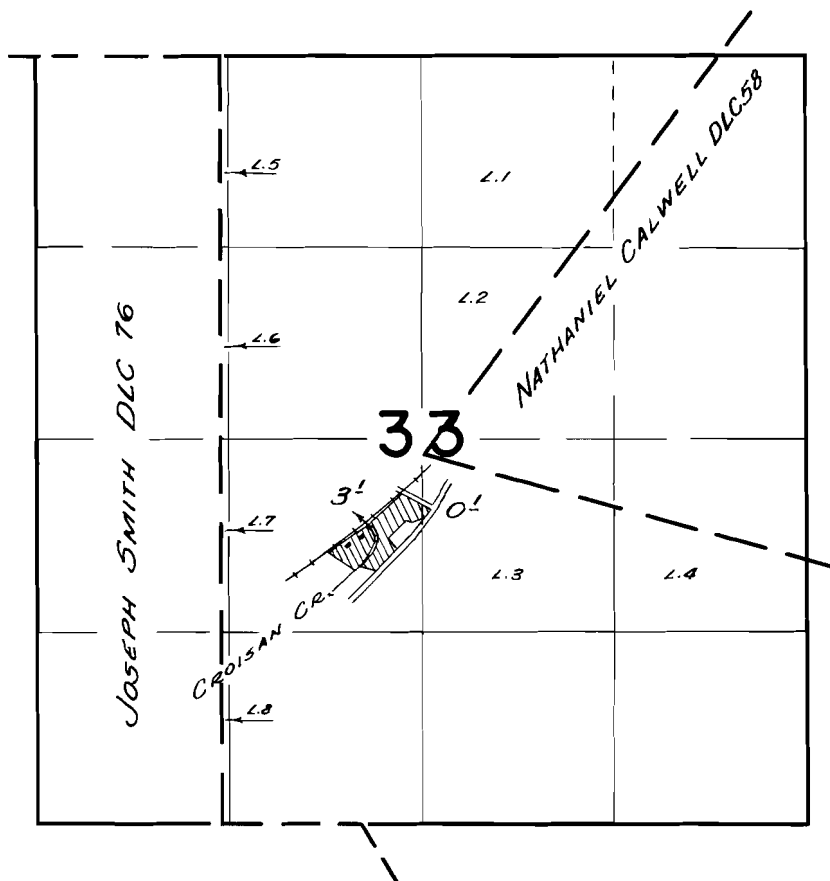

FINAL PROOF SURVEY UNDER

Application No. *R-31888* 31889 Permit No. *R-2081* 25152
IN NAME OF

HAROLD L. BROUSSARD

Surveyed *Sept. 26* 1961, by *CO. Broussard*