


T. 9 S. R. 1 E. W. M.

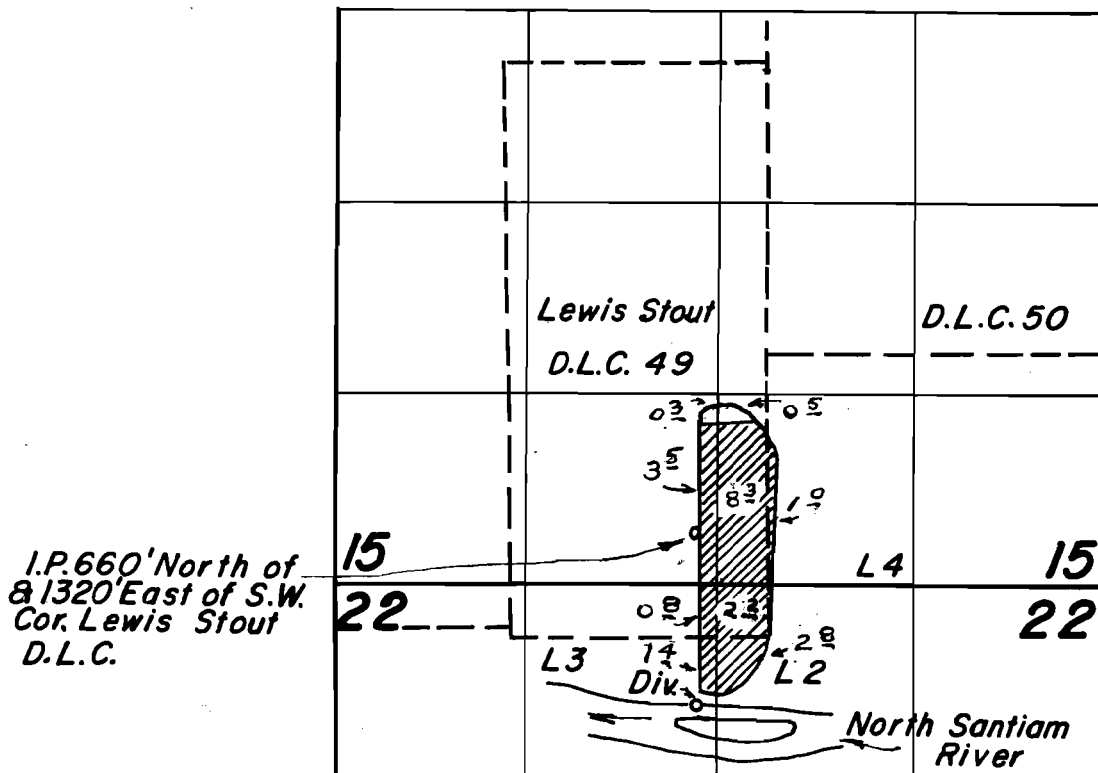

FINAL PROOF SURVEY
UNDER

Application No. 33572 Permit No. 26562
IN NAME OF

LUTHER STOUT

Surveyed June 15 1962, by Floyd L. Siegmund

2-1962-A