


**T. 9 S. R. 1 E. W.M.**

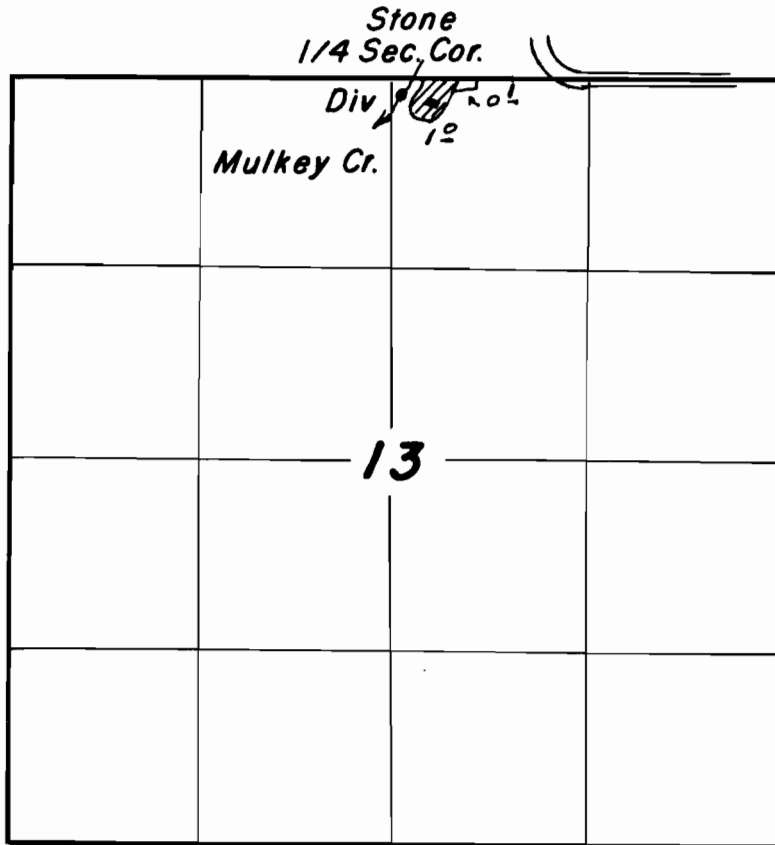

**FINAL PROOF SURVEY**  
UNDER

Application No. 34016 Permit No. 26829  
IN NAME OF

John M. Lingaas

Surveyed June 15 1962, by Phyl L. Siegmund

**2-1962-A**