


T.4N.R.27E.W.M.

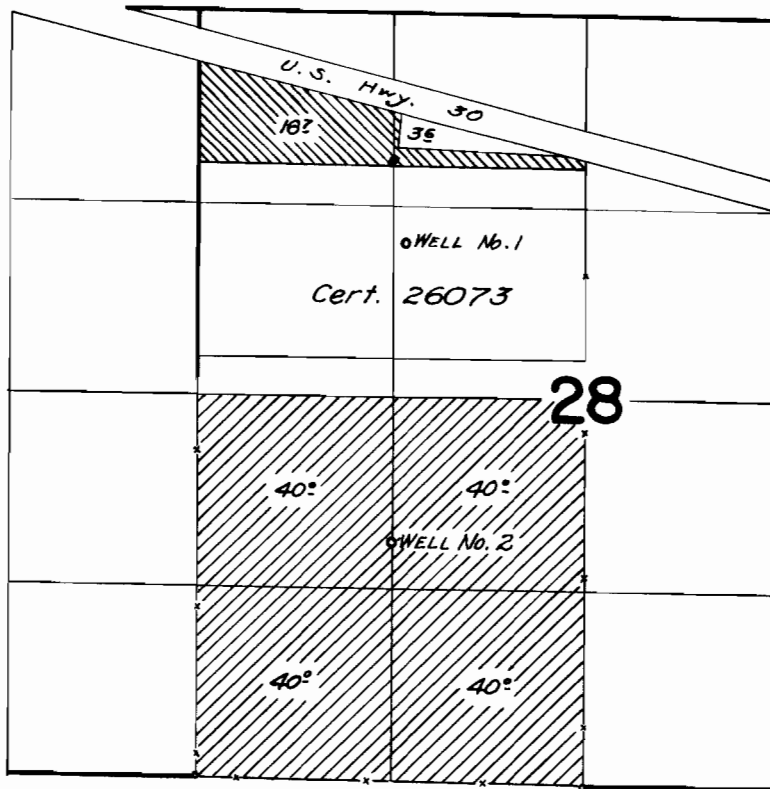

FINAL PROOF SURVEY UNDER

Application No. U-819 Permit No. U-725
IN NAME OF

SCOTT CHAPMAN

Surveyed October 3 1961, by

[Signature]