


T.1S.R.27E.W.M.

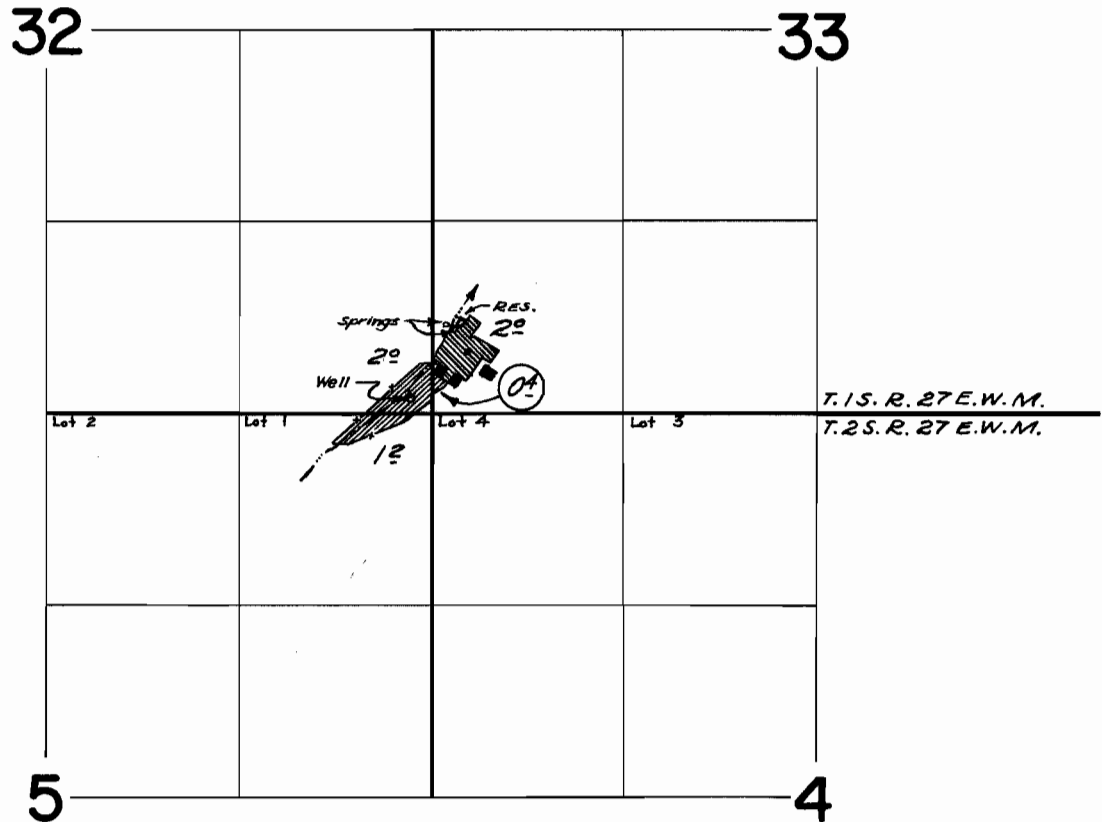

FINAL PROOF SURVEY
UNDER

R-30918 R-1909
30919 24413
Application No. G-473 Permit No. G-351
IN NAME OF

DONALD O. ROBINSON

Surveyed October 6, 1961, by R. Jackson