


20861
30021

T. 1 S. R. 25 E. W. M.

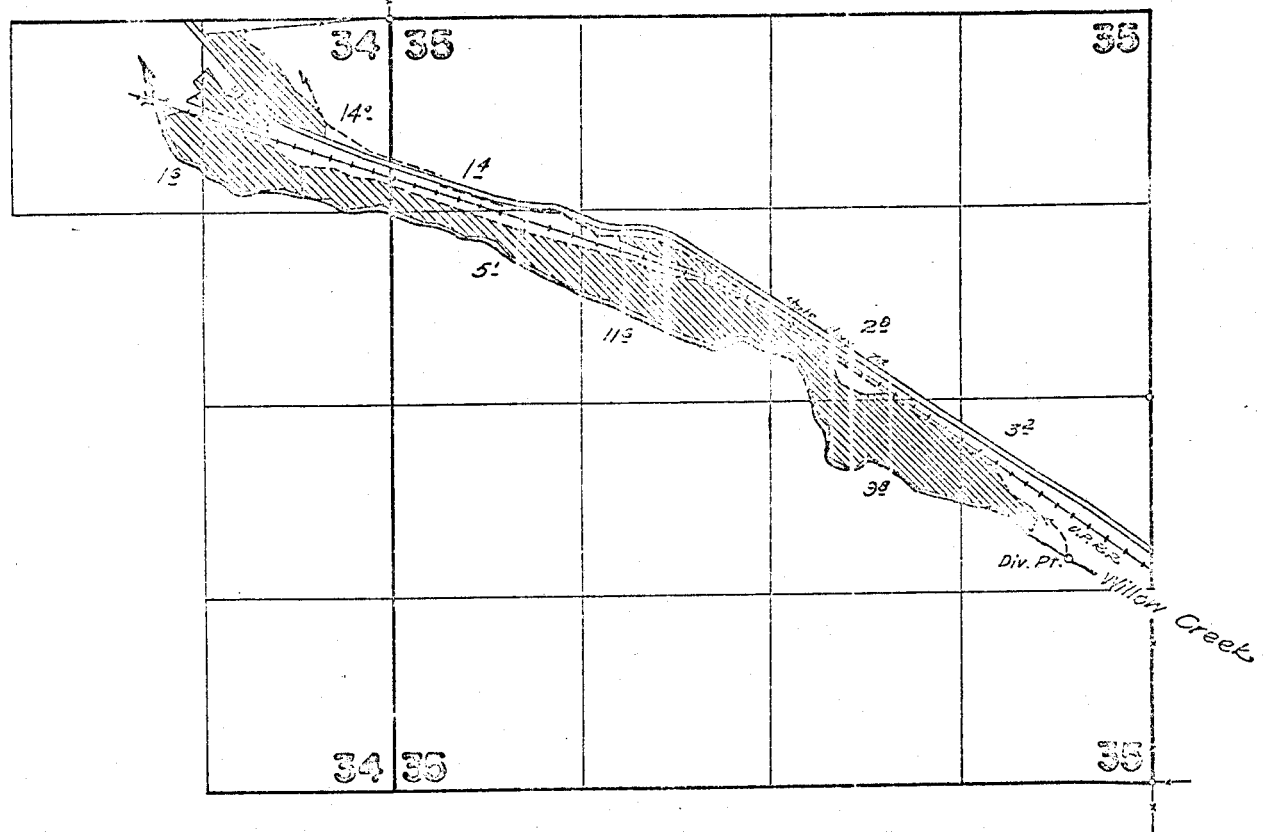

FINAL PROOF OF SURVEY UNDER

Application No. 26629... Permit No. 20861...
IN NAME OF

NEWT O'HARRA

Surveyed October 20, 1958, by M. Fish
October 5, 1961 *[Signature]*