


T. 4 N. R. 25 E. W. M.

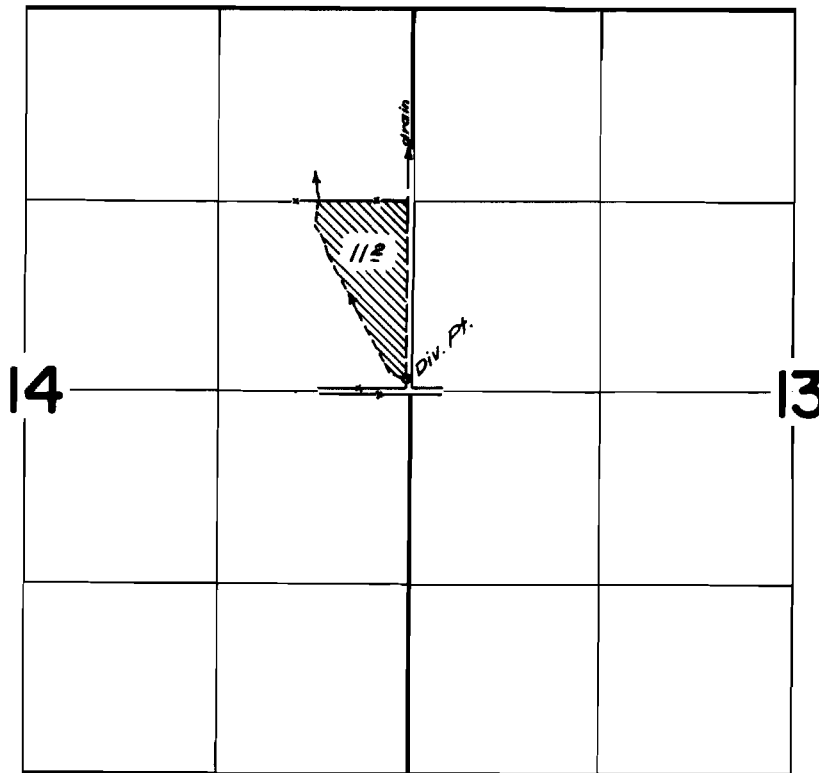

**FINAL PROOF SURVEY**  
UNDER

Application No. 29309 Permit No. 23747  
IN NAME OF

NELS H. KRISTENSEN

Surveyed October 4 1961, by R. Jackson