


T.1S.R.27E.W.M.

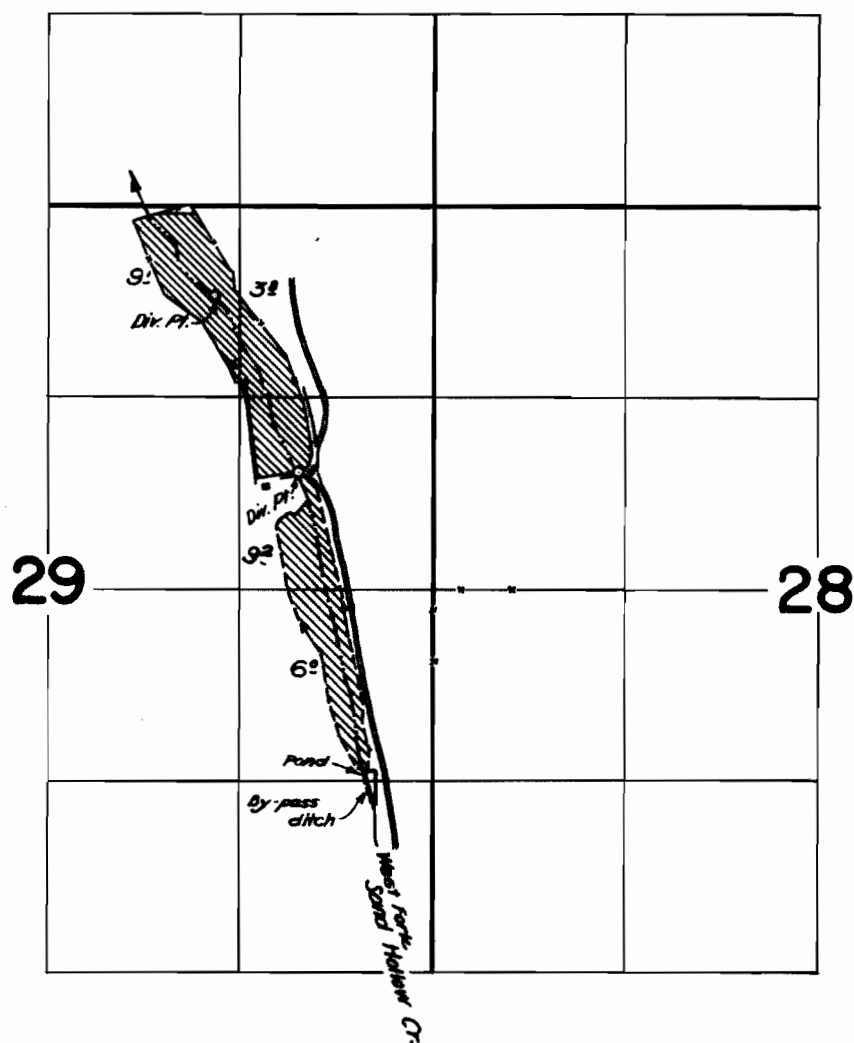

FINAL PROOF SURVEY
UNDER

Application No. **33269**.... Permit No. **26301**....
IN NAME OF

R. B. FERGUSON

Surveyed *October 9 1961*..., by

R. B. Ferguson