


T.1N.R.2E.W.M.

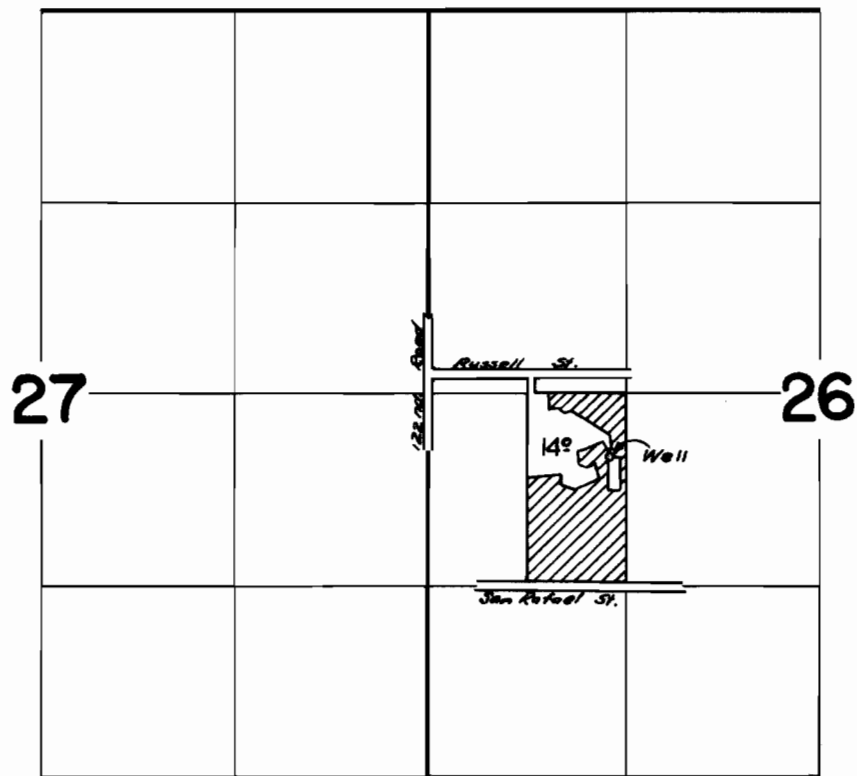

FINAL PROOF SURVEY UNDER

Application No. G-931..... Permit No. G-812.....
IN NAME OF

Parkrose School District No. 3

Surveyed August 18 1961, by C.O. Bartels.....