


T. 1 N. R. 3 E. W. M.

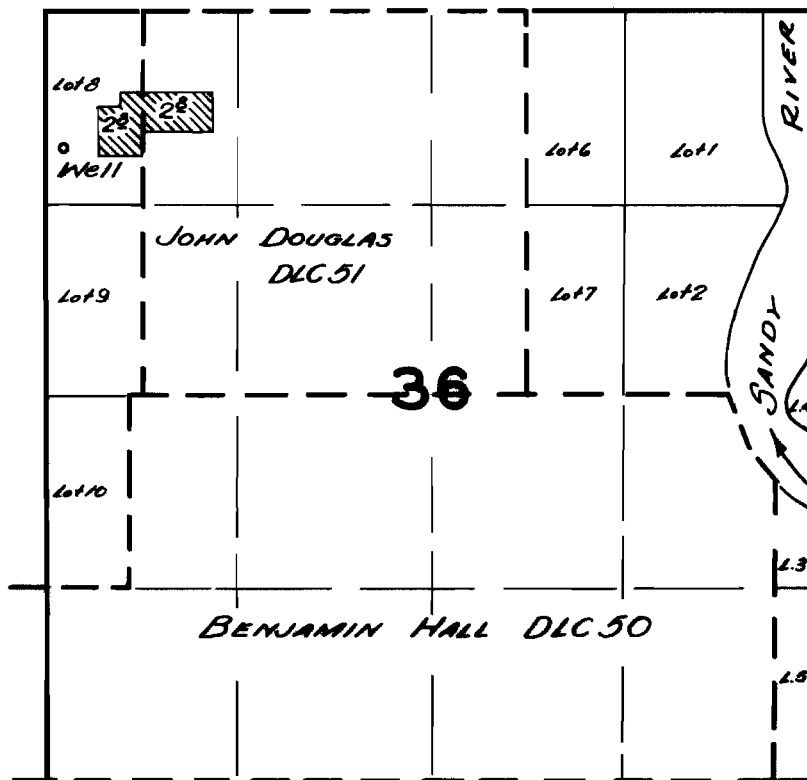

FINAL PROOF SURVEY

UNDER

Application No. G-1200 Permit No. G-970

IN NAME OF

Multnomah County Board of Commissioners
Cemeteries Department

Surveyed Aug. 15, 1961, by C. B. Swartz