


T. 6 S. R. 5 W. W. M.

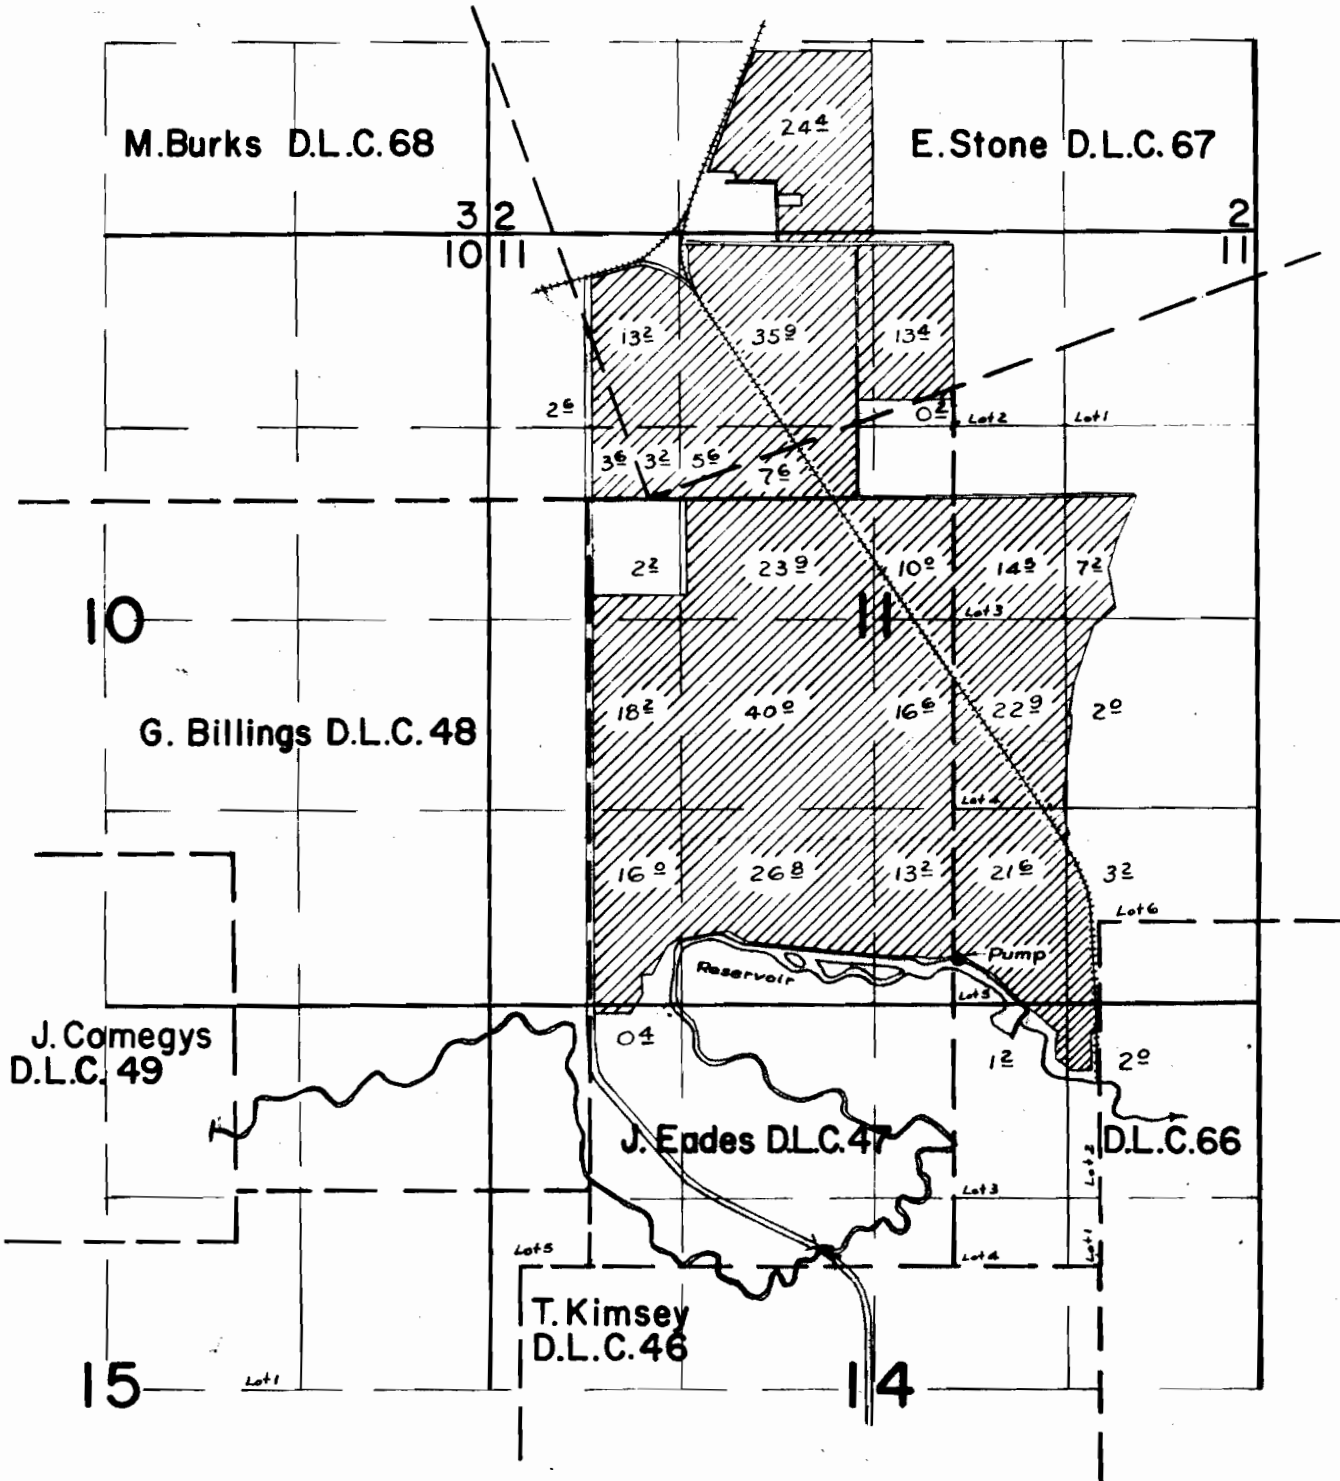

FINAL PROOF SURVEY

UNDEVELOPED

24552

21652

Section No. R-24551 and No. R-1405

IN NAME OF

R. L. WALKER

July 28 61

Surveyed Sept. 9, 1960, by *W. B. Rich*