


T. 1 S. R. 9 W. W. M.

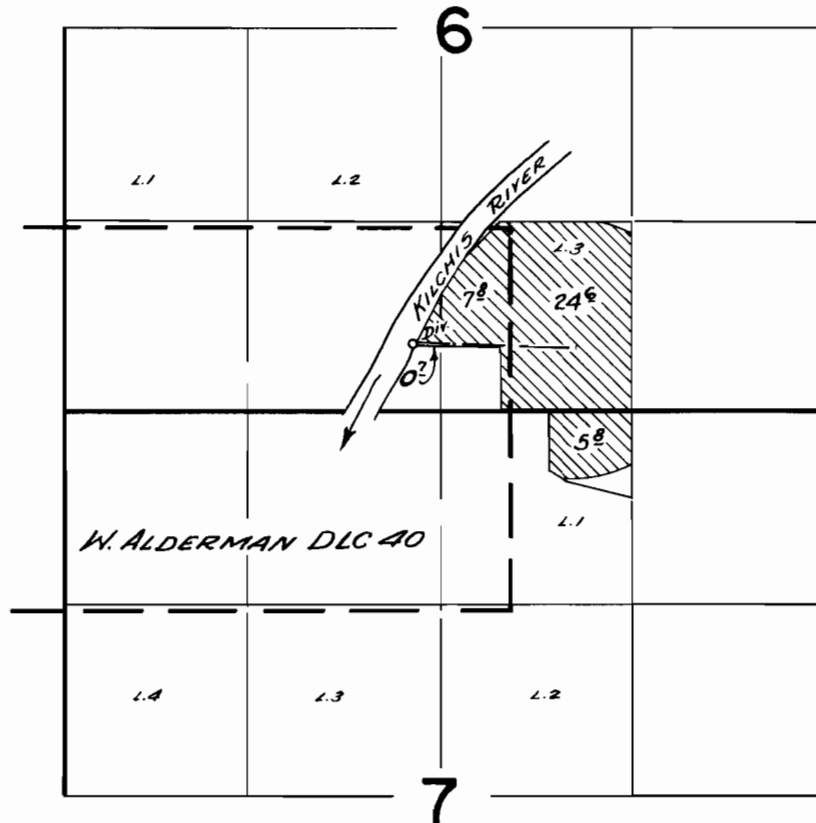

FINAL PROOF SURVEY UNDER

Application No. 29771 Permit No. 23445
IN NAME OF

HENRY LANDOLT JR.

Surveyed June 28 1961, by COBARTIS