


T.1S.R.9W.W.M.

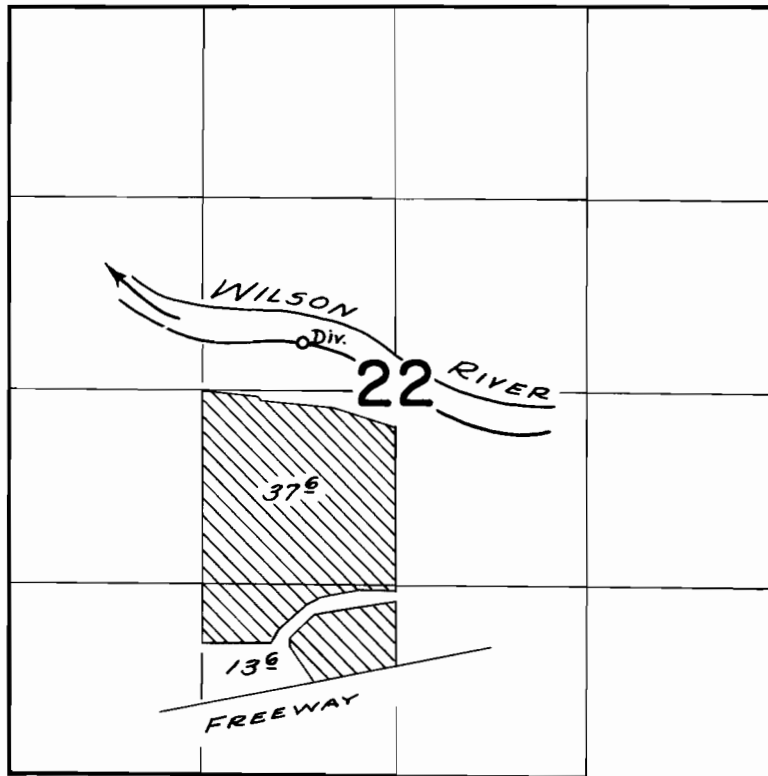

**FINAL PROOF SURVEY**  
UNDER

Application No. 32475 Permit No. 25642  
IN NAME OF

HANS & FRANCES LEUTHOLD

Surveyed June 29, 1961, by CO Bartels