


T. 5&6S. R. 5W. W.M.

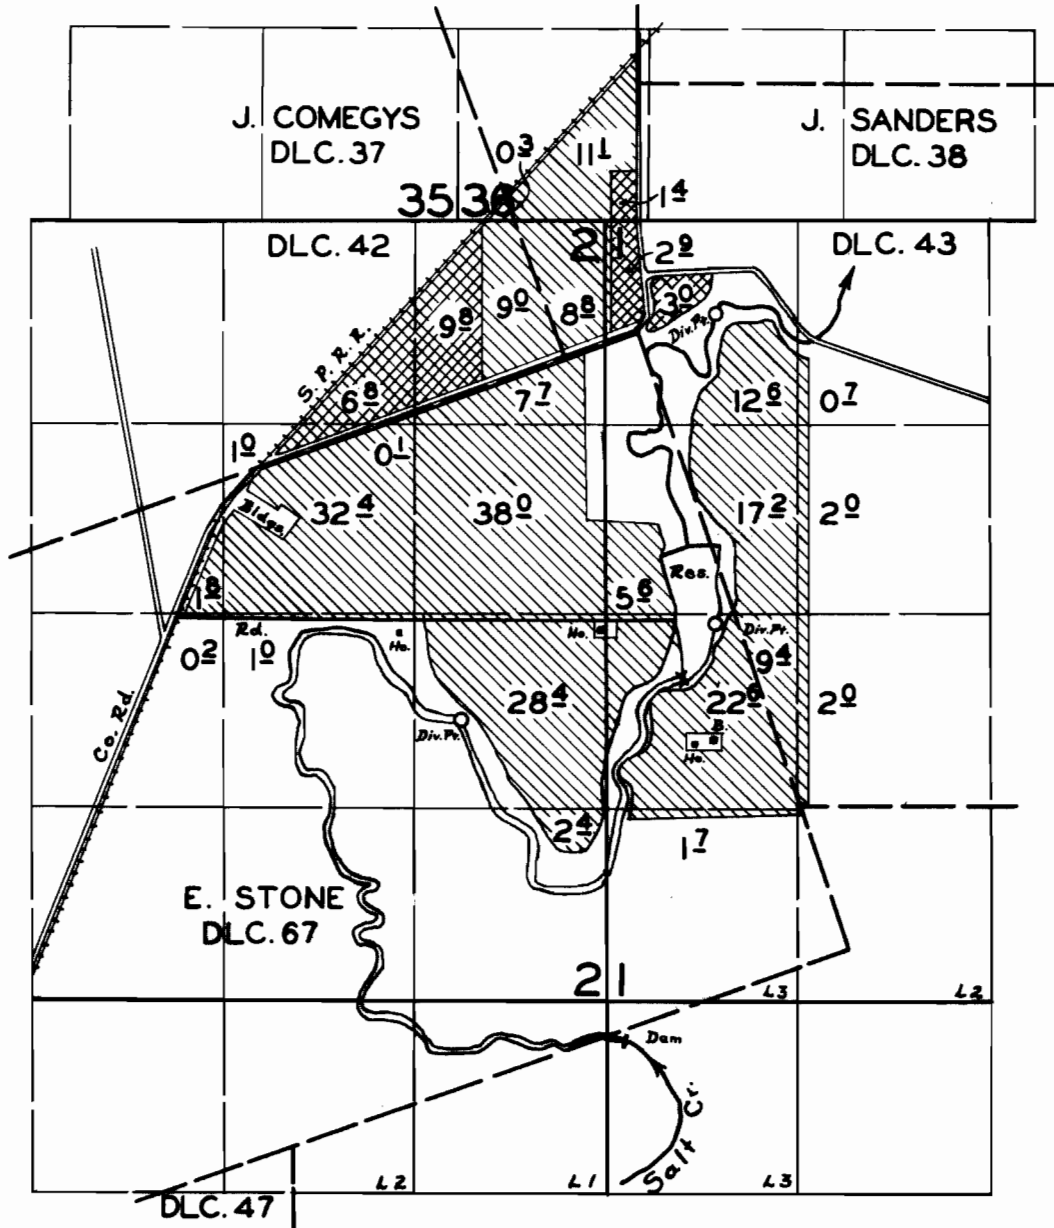

FINAL PROOF SURVEY UNDER

30868

24281

R-23890

R-1086

Application No. 23891 Permit No. 19913

IN NAME OF

R. L. WALKER

Surveyed APR. 7. 1958, by M. BISH

