


T.15S.R.4W.W.M.

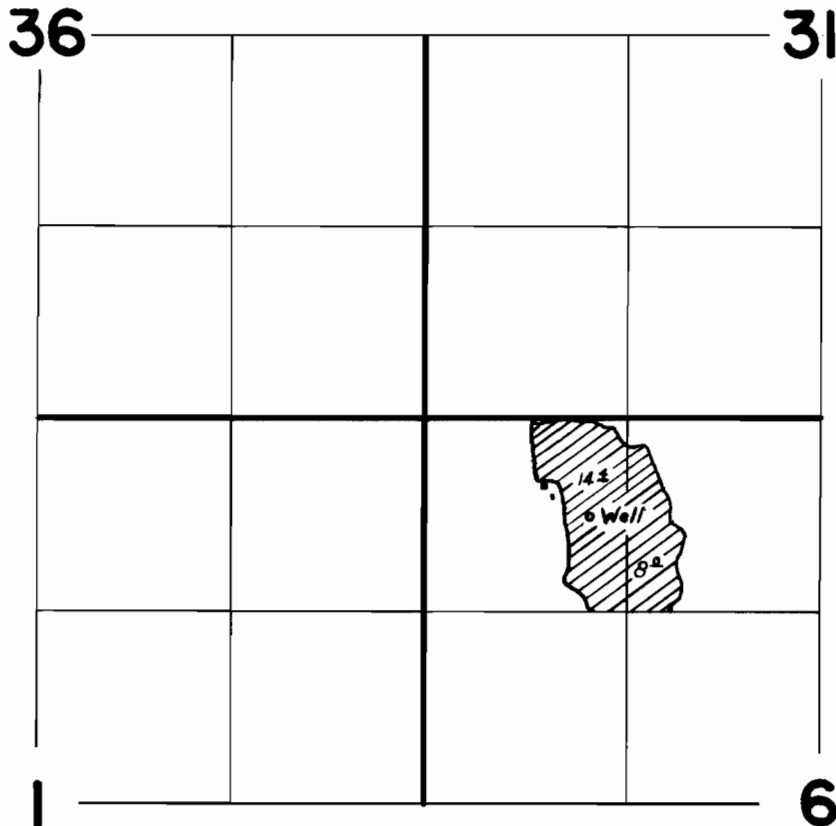

FINAL PROOF SURVEY
UNDER

Application No. G-1134 Permit No. G-1047.
IN NAME OF

.....**Paul Freeman**.....

Surveyed June 12, 1961, by C.O. Bartels.....