


T. 11 S. R. 4 W. W.M.

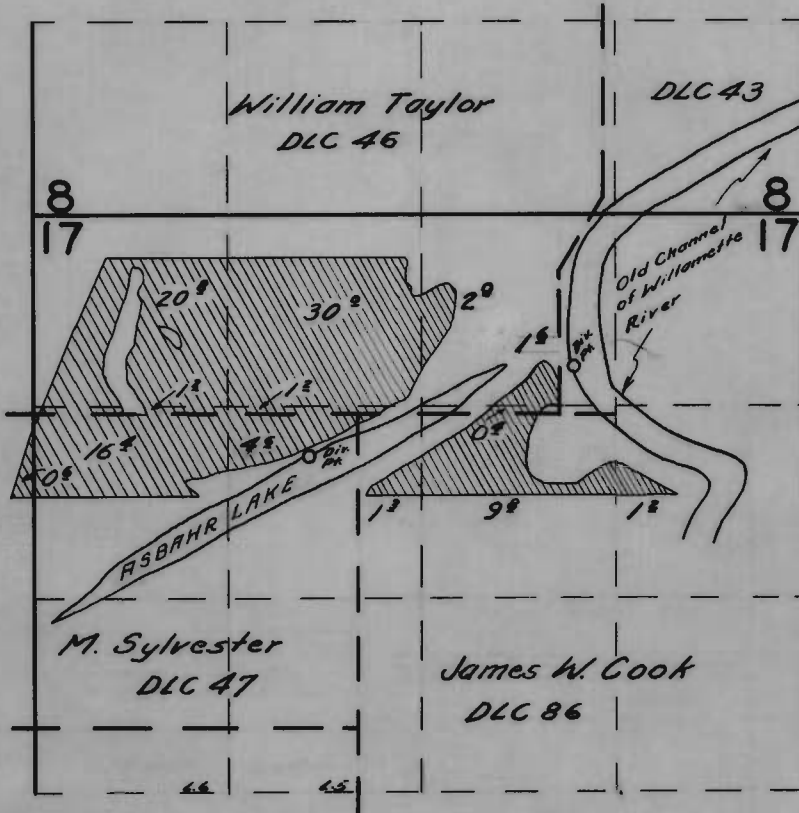

FINAL PROOF SURVEY

UNDER

Application No. 26755 Permit No. 21260

IN NAME OF

W. H. TREMAINE

Surveyed Aug. 15, 1956, by C. O. Bartels