


T.14 S.R.8W.W.M.

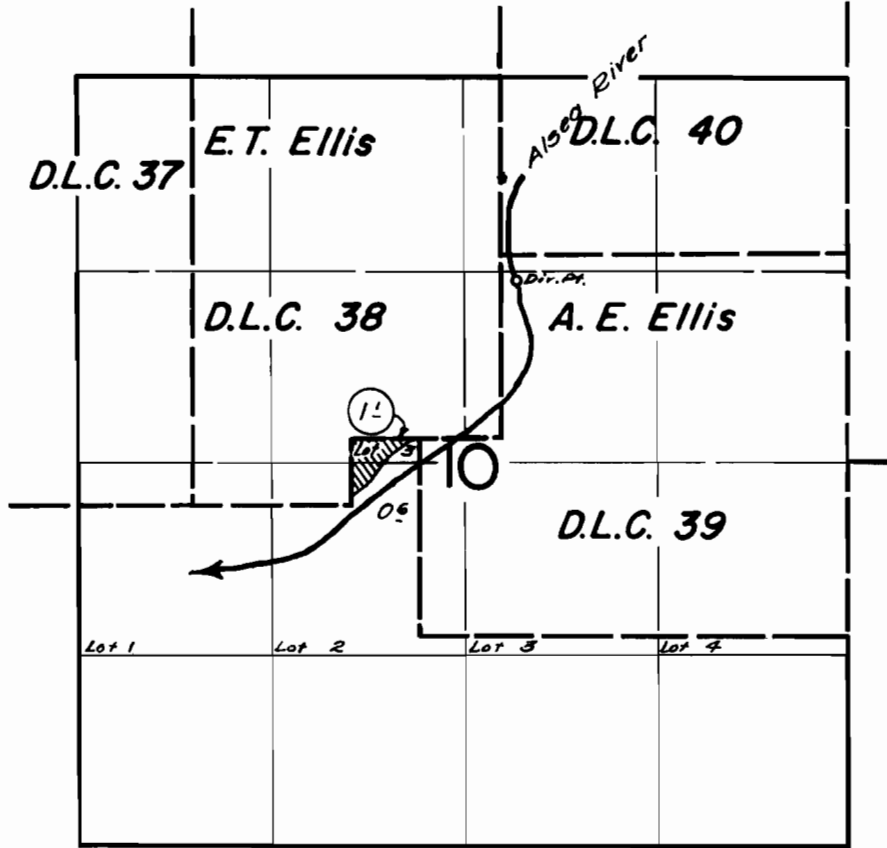

**FINAL PROOF SURVEY**  
UNDER

Application No. 31955..... Permit No. 25208....  
IN NAME OF

O. C. & C.E. MARTIN

Surveyed July 28, 1961., by C.O. Bartels..