


T.2S.R.5E.W.M.

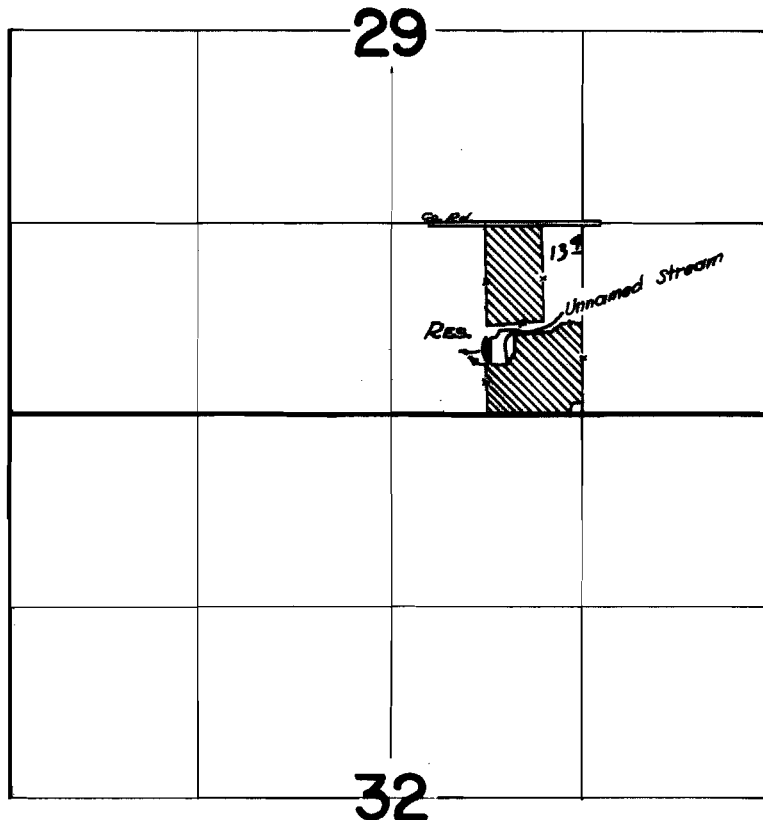

FINAL PROOF SURVEY

UNDER

R-30288

R-1837

Application No. ~~30289~~ Permit No. ~~24068~~

IN NAME OF

WAYNE & CORA OLNEY

Surveyed *April 25* 19*61*..., by *Chapman*