


# T.28S.R.14W.W.M.

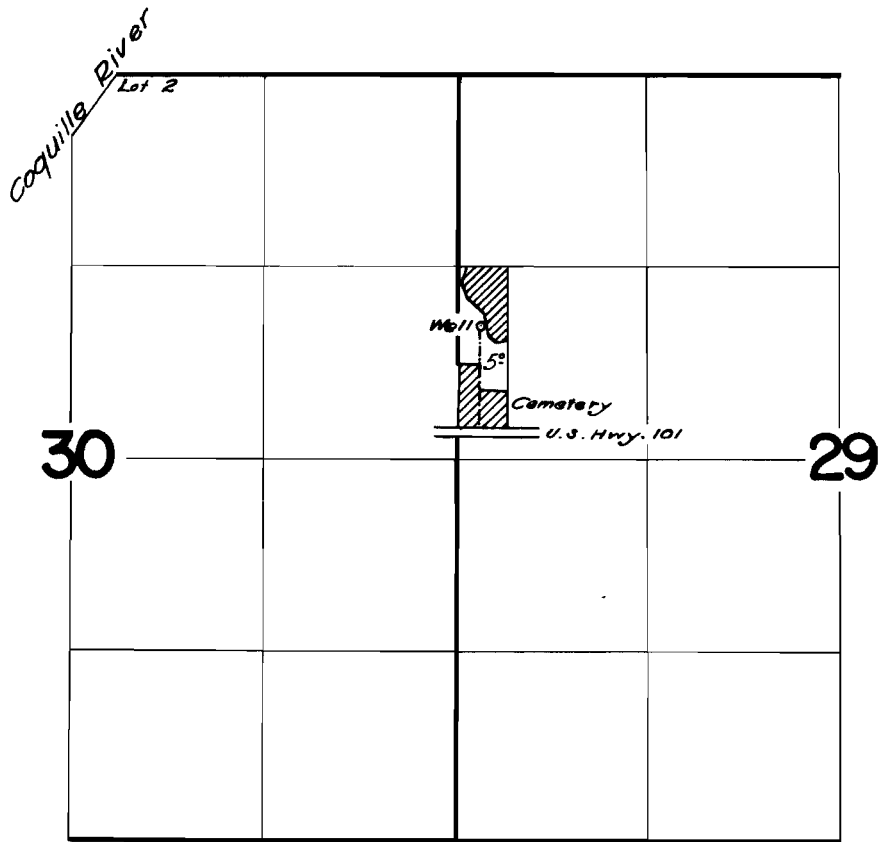

## FINAL PROOF SURVEY UNDER

Application No. **G-771** Permit No. **G-661**  
IN NAME OF  
**Bandon Lodge No. 133**  
**Independent Order of Oddfellows**

Surveyed *August 5, 1961*, by *C.O. Bartels*.