


T.28-29S. R.14 W.W.M.

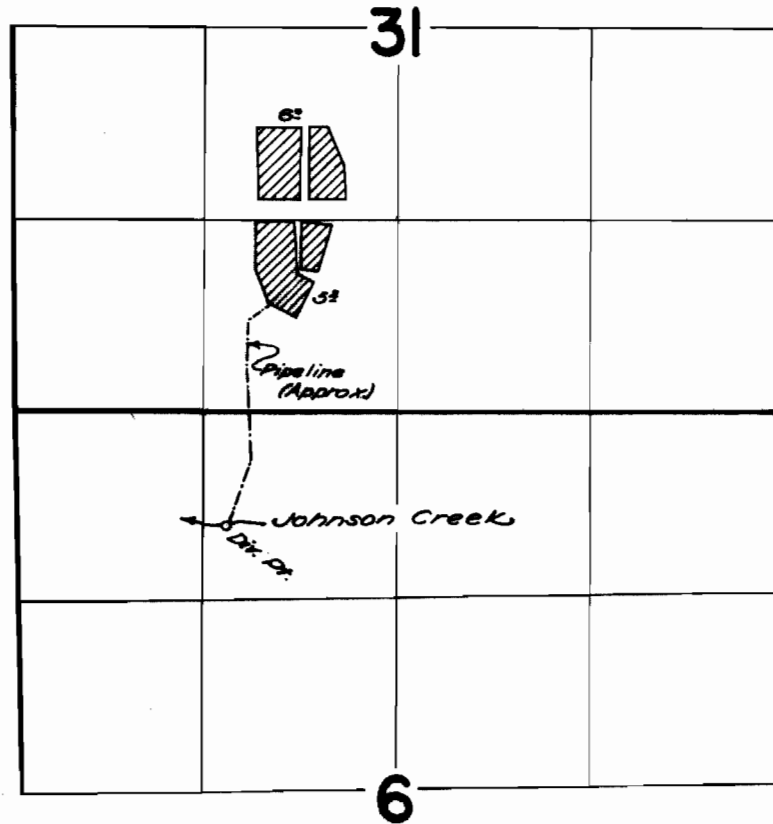

**FINAL PROOF SURVEY**  
UNDER

Application No. **28952**.... Permit No. **21174**.....  
IN NAME OF

.....**JACK DEAN**.....

Surveyed *August 4, 1961*., by *C.O. Bartels*..